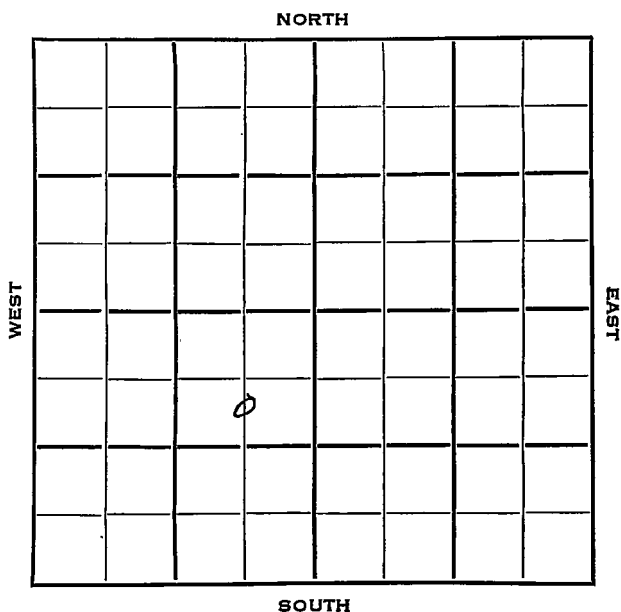


Section 22 Township 22 Range 11WWell No. #2 SuttonCompany Sunray Oil Company

Stafford

Sec. 22 Twp. 22 R. 14W

Well No. #2 Sutton Farm

Sunray Oil Company Company

W. Oscar Pool Contractor

990

Ft. from N. Line


Ft. from S. Line

660

Ft. from E. Line

Ft. from W. Line

C S L NE SW

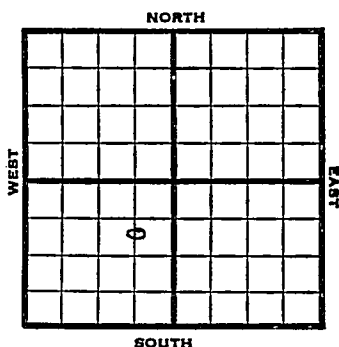

1953	Elev. 1945' REPORT
3/11	Location
3/18	8" @ 403'
3/26	Heeb 3338' Lans 3478
4/2	Drlg. 3520'
4/9	NR
4/15	NR
	Spud 3-16-53
	Oil Well
	TD 3608
	8" @ 403'
	Heeb 3338, Lans 3478,
	DST 3596-3608 open 1 hr, rec 960' clear
	oil 180' ocm, 1000#
	TD 3608
	5" @ 3601
	WCO to 3608
	S/ 7 boph 8 hr. 1500 A F/ 185 ho
	7 hr. P/ 10 boph
	Comp. 288 bopd.
	COMPLETED

County Stafford State Kansas

Sec. 22 (Blk. Twp.) 22 (Sur. Rge.) 14W Map No.

Operator Sunray Oil

Well No. 2 Farm Sutton

Elev.	Location	C S T. NE SW
-------	----------	--------------

FIRST REPORT

990 Ft. From N Line SW

660 Ft. From T Line Quarter

1st. Report MAR 11 1953

Completion

Remarks

Spudding Date _____

Drig. Data W. Oscar Pool

Location


J. G. McGEHEE

County Stafford State Kansas
 Sec. 22 (Blk.
Twp.) 22 (Sur.
Rge.) 14W Map No.

Operator Sunray Oil

Well No. 2 Farm Sutton

Elev. 1945 Location C S L NE SW

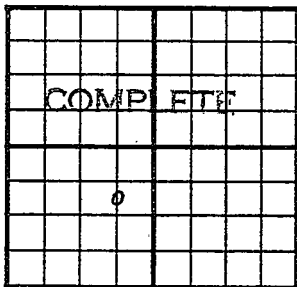

990Ft. From N Line SW

660Ft. From E Line Quarter

1st. Report

Completion APR 15 1953

Remarks W. Oscar Pool

Spudding Date 3-16-53

Drilg. Data Oil well TD 3608

8" @ 403 Heeb. 3338 Lans. 3478

DST 3596-3608 open 1 hr. Rec. 960' clean

oil 180' ocm 1000# TD 3608

5" @ 3601 CO to 3608 S/ 7 boph 8 hr.

1500 A F/ 185 bo 7 hr. P/ 10 boph

Comp. 288 bopd

J. G. McGEHEE