


Section 22 Township 22 Range 15W

Well No. #1 Smith

Company Westgate-Greenland

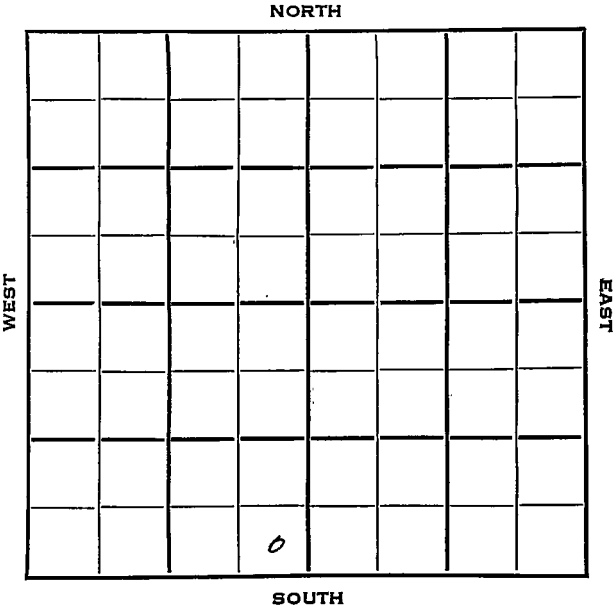

Pawnee

22

22

15W

Sec. _____ Twp. _____ R. _____

Well No. #1 Smith Farm _____Westgate-Greenland

Company _____

Westgate-Greenland

Contractor _____

Wildcat

_____ Ft. from N. Line

330


_____ Ft. from S. Line

330

_____ Ft. from E. Line

_____ Ft. from W. Line

SE SE SW

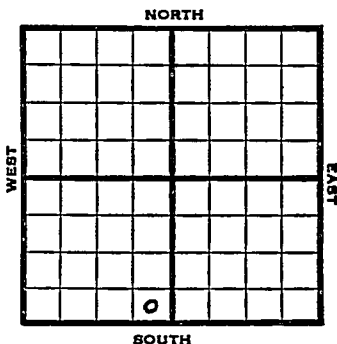

A1953 Elev. 1993' REPORT

1/28 Spud 1-25-53

8" @ 203

Drlg. 1930

2/5 Heeb 3398, Br 1i 3519, Lans 3529

DST 3592-3640, 1 hr., 675' SW 1190#

DST 3647-59, 1 hr., 15' M, 660#

DST 3663-3708, 1 hr., 120' v hly o& gcm, 80' ocm, 360#

Drlg. 3710'

2/12 B KC 3759, Cong 3861, V 3879

DST 3710-50, 1 hr., 45' M,

Simp 3927, Arb 3956

DST 3958-76 1 hr., 3340' oil, 60' O&GCM, 1200#

DST 3978-88, 1 hr., 3720'

gassy oil, 1400#

DST 3991-4003, 1 hr., 2910'

sulp wtr 1300#

RTD 4013

5" @ 4011

2/19 94/3960-80, S/150 B0 1½ hrs., POP

OVER

#1 Smith

1953
2/25

Spud 1-25-53

Oil Well

TD 4013

8" @ 203

Heeb' 3398, Br lime 3519, Lans
3529

DST 3592-3640, opn 1 hr., rec.
675' sw, 1190#

DST 3647-59, opn 1 hr., rec.
15' mud, 660#

DST 3663-3708, opn 1 hr., rec.
120' vho & gcm, 80' ocm, 360#

B KC 3759, Cong 3861, Viola
3879

DST 3710-50, opn 1 hr., rec.
45' mud, 110#

Simp 3927, Arb 3956

DST 3958-76, opn 1 hr., rec.
3340' oil, 60' o & gcm, 1200#

DST 3978-88, opn 1 hr., rec.
3720' gassy oil, 1400#

DST 3991-4003, opn 1 hr., rec.
2910' sul wtr., 1300#

TD 4013,

5" @ 4011

94/3960-80, S/150 bo 1½ hrs.,
Comp. 2822 bopd 4% wtr.

COMPLETED

County **Pratt** State **Kansas**

Sec. 22 (Blk. Twp.) 22 (Sur. Rge.) 15W Map No.

Operator **Westgate-Greenland**

Well No. 1 Farm Smith

Elev.	Location	SE	SE	SW
-------	----------	----	----	----

FIRST REPORT

330 Ft. From S Line SW

330 Ft. From E Line Quarter

1st. Report JAN 28 1953

Completion _____

Remarks


Westgate-Greenland - Contr

Spudding Date . 1-25-53

Drig. Data **Wildcat**

8th @ 203 drlg. 1930

County Pawnee State Kansas
 Sec. 22 (Blk. 22) (Sur. 15W) Map No. 15W
 Operator Westgate-Greenland
 Well No. 1 Farm Smith
 Elev. 1993 Location SE SE SW

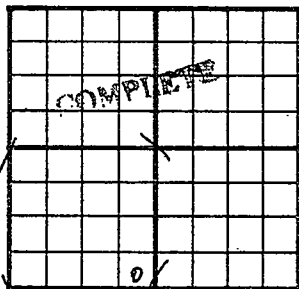

330 Ft. From S Line SW

330 Ft. From E Line Quarter

1st. Report

Completion FEB 25 1953

Remarks Wildcat

Westgate-Greenland - Contr

Spudding Date 1-25-53

Drilg. Data Oil well TD 4013

8" @ 203 Heeb. 3398 Br. lime 3519

Lans. 3529 DST 3592-3640 open 1 hr.

Rec. 675' sw 1190# DST 3647-59

open 1 hr. Rec. 15' mud 660#

DST 3663-3708 open 1 hr. Rec. 120' who

& gcm 80' ocm 360# B KC 3759

Cong. 3861 Viola 3879 DST 3710-50

open 1 hr. Rec. 45' mud 110# Simp. 3927

Arb. 3956 DST 3958-76 open 1 hr. Rec.

3340' oil 60' o & gcm 1200# DST 3978-

88 open 1 hr. Rec. 3720' gassy oil

1400# DST 3991-4003 open 1 hr.

Rec. 2910' sul. wtr. 1300# TD 4013

5" @ 4011 94/ 3960-80 S/ 150 bo 1½ hr.

Comp. 2822 bopd 4% wtr.

J. G. McGFHEE