
FORM 51

Pawnee KANSAS

Section 22 Township 22 Range 15 W

Well No. # 3 O. E. Smith

Company Westgate-Greenland & CSO

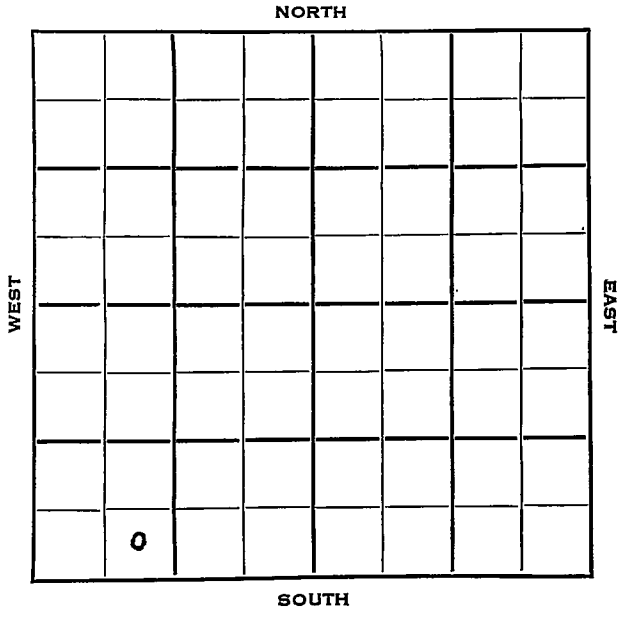

FORM 252-B

Pawnee **KANSAS** ✓

Sec. 22 Twp. 22 R. 15W

Well No. #3 O. E. Smith Farm

Westgate-Greenland &CSO Company

Westgate Contractor

Dunes Pool


____ Ft. from N. Line

330 Ft. from S. Line

____ Ft. from E. Line

990 Ft. from W. Line

SE SW SW

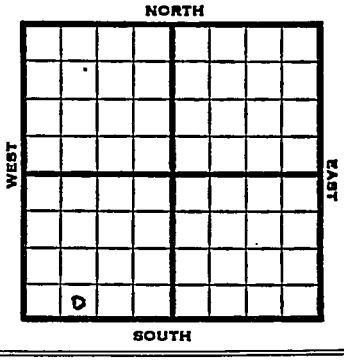

1953	Elev. 1991' REPORT
5/13	MIR
5/21	8" @ 206 Anhy 940 Drlg.2840'
5/28	NR
6/3	"
6/24	Spud 5-13-53 Oil well TD 3981 8" @ 206 Anhy 940 Heeb 3394 Br. lime 3515 KC 3525 B KC 3776 Cong. 3783 Viola 3862 Simp 3903 Arb. 3963 DST 3965-73 open 1 hr rec 1305' gas 1515' GCO 1290# DST 3975-81 open 1 hr rec 705' gas 1815' oil, 60' HO & GCM 1270# TD 3981 5" @ 3981 35/3976-80 FU oil & wtr. 24/3966-74 32/3966-74 S/3 BOPH 500 A S/65 BOPH Comp. 3000 BOPD **COMPLETED**

FORM 275 FOR SALE BY KANSAS BLUE PRINT CO.


County Pawnee State Kansas

Sec. 22 (Blk. Twp.) 22 (Sur. Rge.) 15W Map No.

Operator Westgate-Greenland & CSO

Well No. 3 Farm O. E. Smith

Elev. Location SE SW SW

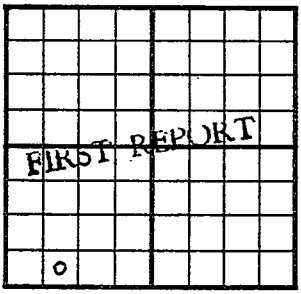

330 Ft. From S Line SW

990 Ft. From W Line Quarter

1st. Report MAY 1 3 1953

Completion

Remarks

Westgate- Contr.

Spudding Date

Drlg. Data Dunes Pool

M I R

J. G. McGEHEE

FORM 275 FOR SALE BY KANSAS BLUE PRINT CO.


County Pawnee State Kansas

Sec. 22 (Blk. / Twp.) 22 (Sur. / Rge.) 15W Map No.

Operator Westgate-Greenland & CSO

Well No. 3 Farm O. E. Smith

Elev. 1991 Location SE SW SW

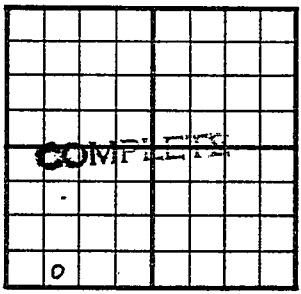

330 Ft. From S Line SW

990 Ft. From W Line Quarter

1st. Report

Completion JUN 24 1953

Remarks Dunes Pool
W-G - Contr.

Spudding Date 5-13-53

Drlg. Data Oil well TD 3981

8" @ 206 Anhy 940 Heeb. 3394

Br. lime 3515 KC 3525 B KC 3776

Cong. 3783 Viola 3862 Simp. 3903

Arb. 3963 DST 3965-73 open 1 hr.

Rec. 1305' gas 1515' gco 1290#

DST 3975-81 open 1 hr. Rec. 705' gas

1815' oil 60' ho & gcm 1270#

TD 3981 5" @ 3981 35/ 3976-80

FU oil & wtr. 24/ 3966-74 32/ 3966-74

S/ 3 boph 500 A S/ 65 boph

Compl 3000 bopd

J. G. McGEHEE