

KANSAS

Stafford

Section 22 Township 22 Range 12WWell No. #1 ~~Verian~~ DurhamCompany Barnsdall etal.

NORTH

							Q

SOUTH

WEST EAST

KANSAS

Stafford

Sec. 22 Twp. 22 R. 12W

Well No. #1 Werhan *Werhan* Farm

Barnsdall et al Company


Heyen

990 Ft. from N. Line

 Ft. from S. Line

330 Ft. from E. Line

 Ft. from W. Line

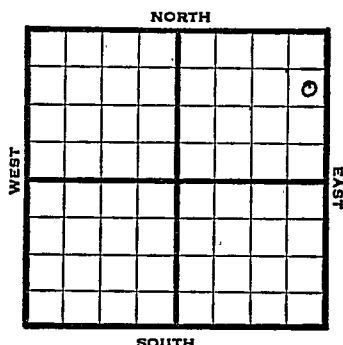

SE NE NE

1948

Elev. 1884' REPORT

1/21

RUR

1/26

8" @ 215'
D. lg 2200'

2/4

Lansing 3313'
Viola 3581'
Simpson 3639'
Arbuckle 3693'
TD 3696'
Run 5"

2/11

5" @ 3693'
RUST

2/18

2 Bailers Oil PH SW

2/25

"

3/3

Pump 29 bbls fluid, 12 hrs.

3/10

"

3/17

"

3/24

"

3/31

"

4/7

Arbuckle 3693'
5" @ 3693'
Pump 14 oil & W Pot.
Gr. 39.90
TD 3696'

COMPLETED

Map No. _____ Sec. 22 Twp. 22 R. 12W

Well No. 1 Werhan

Barnsdall etal. Company

FIRST REPORT Contractor

SE NE NE


SECTION PLAT

990 Ft. from N. Line

_____ Ft. from S. Line

330 Ft. from E. Line

_____ Ft. from W. Line

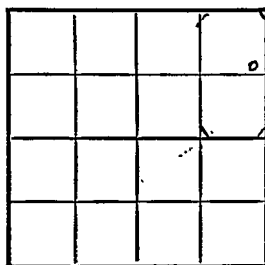

Stafford County

Location _____

Rig up _____

Drilling and Remarks:

R U R

RECORD

Cased _____ in, _____ ft.

Sand _____

Gas _____

Oil _____

Total Depth _____

PRODUCTION

1st 24 hrs. Nat. _____

1st 24 hrs. after shot _____

Gas _____ Cu. Ft.

Dry Hole _____

Abandoned _____

Date

JAN 21 1948 19 S. J. LEWIS Scout

Map No. 46 Sec. 22 Twp. 22 R. 12W

Well No. 1 Durham

Barnsdall etall Company

CORRECTION Contractor

SE NE NE

SECTION PLAT

			o

990 Ft. from N. Line

Ft. from S. Line

330 Ft. from E. Line

Ft. from W. Line

Stafford County

Location

Rig up

Drilling and Remarks:

Reported

#1 Werhan

RECORD

Cased in., ft.

Sand

Gas

Oil

Total Depth

PRODUCTION

1st 24 hrs. Nat.

1st 24 hrs. after shot

Gas Cu. Ft.

Dry Hole

Abandoned

Date

MAR 10 1948

19

S. J. LEWIS

Scout

Map No. 46 Sec. 22 Twp. 22 R. 12W

Well No. 1 Durham

Barnsdall et al. Company

COMPLETE

Contractor

SE NE NE

E. 1884
SECTION PLAT

990 Ft. from N. Line

 Ft. from S. Line

330 Ft. from E. Line

 Ft. from W. Line

			a

Stafford County

Location

Rig up

Drilling and Remarks:

Cu 8693

5" 8693

Pump 14 oil + 1W
Box

39-3/4

RECORD

Cased in., ft.

Sand

Gas

Oil

Total Depth 3696

PRODUCTION

1st 24 hrs. Nat.

1st 24 hrs. after shot

Gas Cu. Ft.

Dry Hole

Abandoned

Date

APR 7 1948 19

S. J. LEWIS Scout