


Section 22 Township 22 Range 12W

Well No. #1 Fruehauf

Company Derby Oil & Glenn Peel

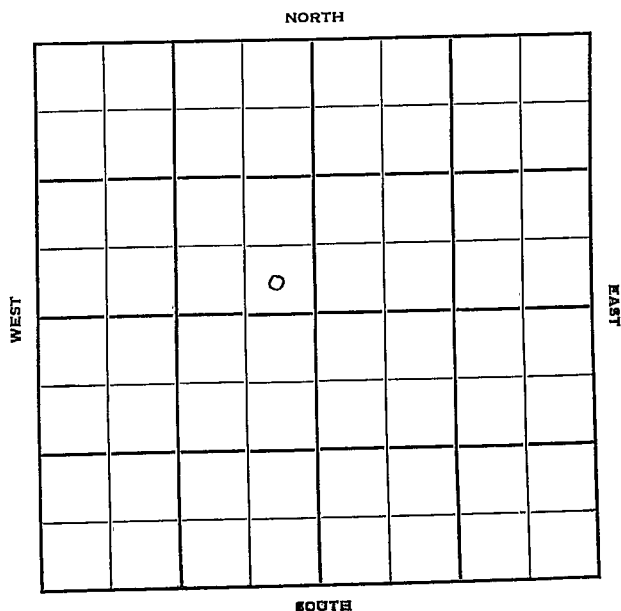

Sec. 22 Twp. 22 R. 12W ✓

Well No. #1 Fruehauf Farm

Derby Oil & Glenn Peel Company

Peel Drlg. - Contr. Contractor

Heyen Pool


 Ft. from N. Line

330' Ft. from S. Line

330' Ft. from E. Line

 Ft. from W. Line

SE SE NW

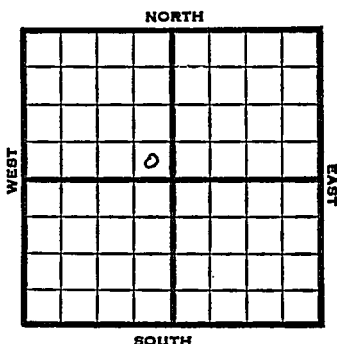

1951 Elev. 1861' REPORT

8/15

Location

9/5

D&A TD 3696'

8" @ 252'

HeeB 3161 Br. Lime 3293 KC 3316

Viola 3582 Simp. 3629 Arb. 3688

DST 3503-30 open 1 hr. rec. 15'

SO & GCM


DST 3573-3600 open $\frac{1}{2}$ hr. rec. 40'
mud

DST 3689-96 open 45 min. rec. 225'
sulphur wtr.

D&A

ABANDONED

County Stafford State Kansas
 Sec. 22 (Blk. Twp.) 22 (Sur. Rge.) 12W Map No. _____
 Operator Derby Oil & Glenn Peel
 Well No. 1 Farm Fruehauf
 Elev. _____ Location SE SE NW

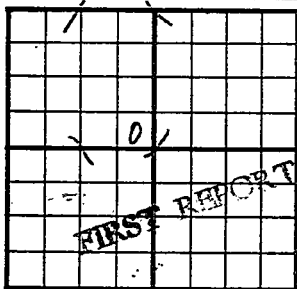

330 Ft. From S Line NW
330 Ft. From E Line Quarter

1st. Report AUG 15 1951

Completion _____

Remarks _____

Peel Drig. - Contr.

Spudding Date _____


Drig. Data _____

Heyen Pool

Location

J. E. TYRA

County Stafford State Kansas
 Sec. 22 (Blk.) 22 (Sur.) 12W Map No. _____
 Operator Derby Oil & Glenn Peel
 Well No. 1 Farm Fruehauf
 Elev. 1861 Location SE SE NW

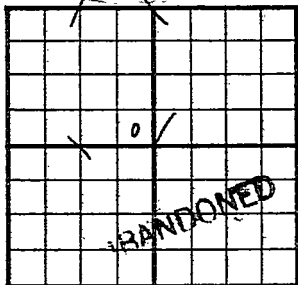

330 Ft. From S Line NW
330 Ft. From E Line Quarter

1st. Report _____

Completion SEP 5 1951

Remarks Heyen Pool

Peel Drlg. - Contr.

Spudding Date _____

Drlg. Data D & A TD 3696

8" @ 252 Heeb. 3161 Br. lime 3293

KC 3316 DST 3505-30 open 1 hr.

Rec. 15' so & gcm Viola 3582 DST 3573-

3600 open $\frac{1}{2}$ hr. Rec. 40' mud

Simp. 3629 Arb. 3688 DST 3689-96

open 45 min. Rec. 225' sulphur water

D & A

J. E. TYRA