
FORM 51 25M 8-50 WESTERN

Stafford KANSAS

Section 22 Township 22 Range 12 W

Well No. # 2 Smith

Company Musgrove Pet.

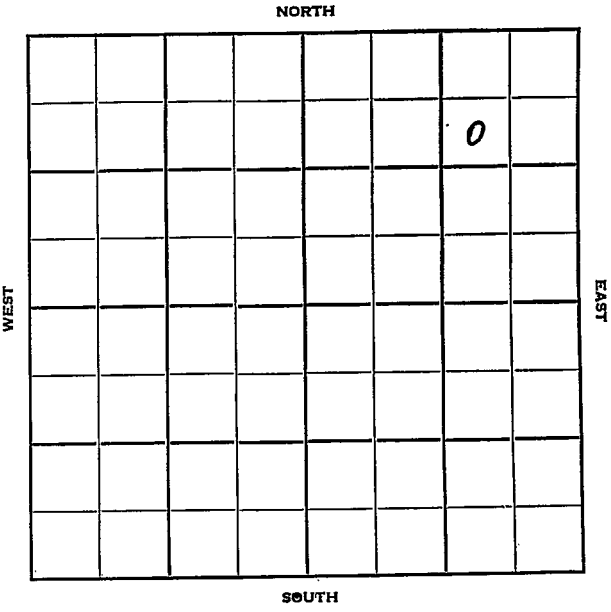

FORM 252-B
10M 8-51 TPCO. Stafford

KANSAS

Sec. 22 Twp. 22 R. 12W

Well No. #2 Smith Farm

Musgrove Pet. Company

Musgrove Contractor


990 Ft. from N. Line

Ft. from S. Line

990 Ft. from E. Line

Ft. from W. Line

SW NE NE

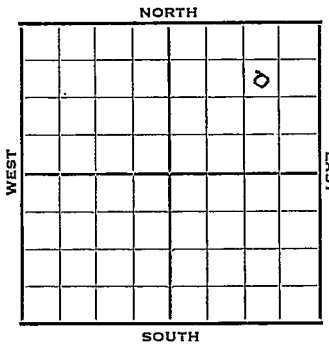

1952	Elev. 1876' REPORT
6/25	Spud 6-23-52 8" @ 222'
7/2	Anhy 1010' Drlg. 2933'
7/9	Ft. Riley 1440' Heeb 3165' Br li 3293 Lans. 3306' Simp. 3685' Arb. 3688' DST 3676-91, 1 hr, 125' OCM, 25' wtr. TD 3691' 5" @ 3686'
7/17	DP CO 3691' S/2½ BOPH 300 A S/6 BOPH Pipe caved.
7/23	Swedging pipe
7/30	Sq. off
8/6	NR
8/13	To work over.
8/20	Shot pipe off 1900' set whipstock 1824 Drlg. 2086
8/27	Drlg. 3420'
9/3	TD 3685 5" @ 3681
9/10	CO 3685 6 galoph DD 3687 TD No increase 300 A S/6 BOPH for 6 hrs.
9/17	5 Boph
9/24	P/32 BO & 50 BWPD

OVER

1952

10/1 P/ 38 BO & 60 Bwpd
10/8 "
10/15 "
10/22 P/27 BO plus 45 BWPD
10/29 Spud 6-23-52
Oil Well
TD 3687'
8" @ 222
Anhy 1010, Ft. Riley 1440', Heeb 3165',
Br. lime 3293', Lans 3306', Simp. 3685',
Arb. 3688
DST 3676-91, opn 1 hr., rec. 125' ocm,
25' wtr.,
TD 3691
5" @ 3681'
CO to 3691' S/2½ boph 300A
S/6 boph pipe caved
Set Whipstock 1824
TD 3685'
5" @ 3681'
CO to 3685 6 goph DD 3687 300A
S/6 boph 5 boph P/32 bo 50 bwpd
P/38 bo 60 bwpd
Comp. 27 bopd 45 bw

COMPLETED

FORM 275 FOR SALE BY KANSAS BLUE PRINT CO.


County Stafford State Kansas

Sec. 22 (Blk. Twp.) 22 (Sur. Rge.) 12W Map No.

Operator Musgrove Pet.

Well No. 2 Farm Smith

Elev. Location SW NE NE

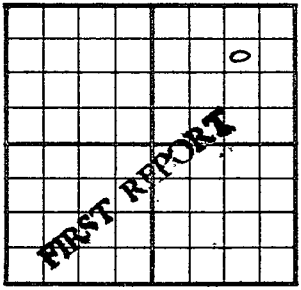

990 Ft. From N Line NE

950 Ft. From E Line Quarter

1st. Report JUN 25 1952

Completion

Remarks

Musgrove - Contr.

Spudding Date 6-23-52

Drlg. Data

8⅝" @ 222

J. G. McGEHEE

FORM 275 FOR SALE BY KANSAS BLUE PRINT CO.


County Stafford State Kansas

Sec. 22 (Blk. Twp.) 22 (Sur. Rge.) 12W Map No.

Operator Musgrove Pet.

Well No. 2 Farm Smith

Elev. 1876 Location SW NE NE

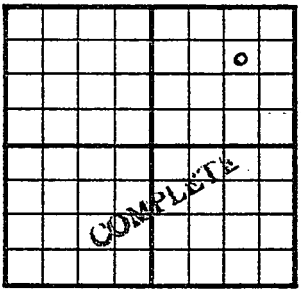

990 Ft. From N Line NE

990 Ft. From E Line Quarter

1st. Report

Completion OCT 29 1952

Remarks

Musgrove - Contr.

Spudding Date 6-23-52

Drlg. Data Oil well TD 3687

8" @ 222 Anhy 1010 Ft. Riley 1440

Heeb. 3165 Br. lime 3293 Lans. 3306

Simp. 3685 Arb. 3688 DST 3676-91

open 1 hr. Rec. 125' ocm 25' wtr.

TD 3691 5" @ 3681 CO to 3691

S/ 2½ boph 300 A S/ 6 boph pipe caved

Set whipstock 1824 TD 3685 5" @ 3681

CO to 3685 6 goph DD 3687 300 A

S/ 6 boph 5 boph P/ 32 bo 50 bwpd

P/ 38 bo 60 bwpd Comp. 27 bopd 45 bw

J. G. McGEHEE