

Section 22 Township 22 Range 31W

Well No. 1 Vashti Russell

Company ~~Carter Oil Company~~ *A. D. McKelvey*

NORTH

	0						

WEST

EAST

SOUTH

Sec. 22 Twp. 22 R. 31W

Well No. 1 Vashti Russell Farm

Carter Oil Company

Rine Drlg. Contractor


330 Ft. from N. Line

Ft. from S. Line

Ft. from E. Line

990 Ft. from W. Line

NE NW NW

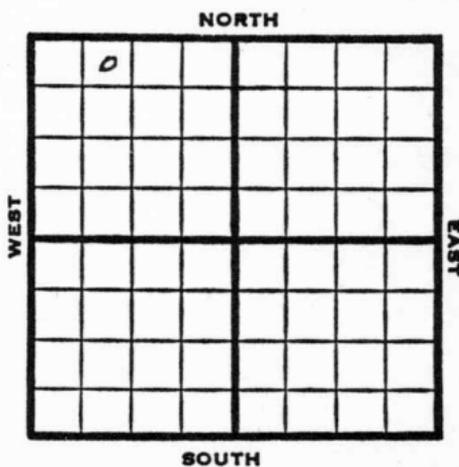

1952 Elev. 2910' REPORT

12/30 MIR  
 1/1 MIR  
 1/8 10" @ 351 DST 2745-75 1/2 Hr. 1 1/2 M Gas  
 90' SW 60' M 495 H 2919

1/22 Win. 2743, Heeb 3971, Lans 4018  
 DST 4286-4328, failed  
 DST 4289-4328, 2 hrs., 2350'  
 sulp wtr. 1175#  
 DST 4705-35, 1 hr., 2' free  
 oil, 50' OCM,  
 Miss 4743  
 DST 4735-54, 2 hrs., 20' M  
 Drlg. 4850'

1/28 Spud 12-31-52 D & A TD 4850'  
 10" @ 351  
 DST 2745-75 open 1/2 hr. rec 1 1/2 MCFG  
 90' SW, 60' mud 495#  
 Win. 2743' Heeb. 3971' Lans. 4018'  
 DST 4286-4328' failed.  
 DST 4289-4328 open 2 hr. rec 2350' sul  
 wtr. 1175#  
 DST 4705-35 open 1 hr. rec 2' free oil  
 30' OCM, 150# Miss 4743'  
 DST 4735-54 open 2 hr. rec 20' mud  
 TD 4850'  
 D & A

ABANDONED

County **Finney** State **Kansas**Sec. **22** (Blk. Twp.) **22** (Sur. Rge.) **31W** Map No.Operator **Carter Oil**Well No. **1** Farm **Vashti Russell**Elev. Location **NE NW NW**

	o				

**330** Ft. From **N** Line **NW****990** Ft. From **W** Line **Quarter**1st. Report **DEC 30 1952**

Completion

Remarks

**Rine Drlg. - Contr.**

Spudding Date

Drlg. Data

**M I R**

County Finney State Kansas

Sec. 22 (Blk. 22 (Sur. 31W (Twp.) 22 (Rge.) 31W Map No.

Operator Carter Oil

Well No. 1 Farm Vashti Russell

Elev. 2910 Location NE NW NW

0					

330 Ft. From N Line NW

990 Ft. From W Line Quarter

1st. Report

Completion JAN 28 1953

Remarks

Rine Drlg. - Contr.

Spudding Date 12-31-52

Drlg. Data D & A TD 4850

10" @ 351 DST 2745-75 open 1/2 hr.

Rec. 1 1/2 mcfg 90' sw 60' mud 495#

Win. 2743 Heeb. 3971 Lans. 4018

DST 4286-4328 failed DST 4289-4328

open 2 hr. Rec. 2350' sul. wtr. 1175#

DST 4705-35 open 1 hr. Rec. 2' free oil

30' ocm 150# Miss. 4743 DST 4735-54

open 2 hr. Rec. 20' mud TD 4850

D & A

J. G. McGEHEE

O.W.W.O.

FORM 513 SUNRAY

County Finney Elev. \_\_\_\_\_  
 Sec. 22 Twp. 22 Rge. 31W  
 Company A.D. McKelvey  
 Farm Name Russell No. 1

TOPS	DEPTH	LOG	DATUM	Loc. in Sec.
Anh.				NE NW NW
Tr.				(OWWO)
Dg.				
Bl.				
L.				Geol. _____
K.C.				Contr. _____
B.K.C.				
Ce.				
C.				Graham-Michaelis
M.				Tools
M.				Pool
K.				Sonderegger
Mz.				
Me.				
V.				
S.				
S.				
A.				
R.				
Pe.				
G.				
T.D.				

0  
 FIRST REPORT  
 DEC 12 '56

Date Comm.

Old Info. Win 2743, REED 4350, D & A. to  
 To PE to Permian

35

Co.

Lsg.

No.

Sec.

T.

R.

County Finney Elev. 2910 DF  
 Sec. 22 Twp. 22 Rge. 31W  
 Company A.L. McKelvey  
 Farm Name Russell No. 1

TOPS	DEPTH	LOG	DATUM	Loc. in Sec.
Anb <u>HCC</u>		<u>2693</u>		<u>NE NW NW</u>
Tp. <u>KFI</u>		<u>2718</u>		
H. <u>WFD</u>		<u>2748</u>		<u>(OWWO)</u>
Tr.				
Dg.				
Bl.				
L.				
K.C.				Geol.
B.K.C.				Cont.
Co.				
C.				<u>Graham-Michaelis</u>
M.				<u>Tools</u>
M. <u>St Louis</u>		<u>4776</u>		<u>Pool</u>
K.				<u>Sonderegger</u>
Mz.				
Ma.				
V.				
S.				
S.				
A.				
R.				
PE				
G.				
TD				

COMPLETE  
 JAN 8 57

Date Comm.

Old Info. Win 2743, RED 4850, D & A. to  
 To PB to Permian DEC 19 56 ✓ DEC 26 56 Co 2796  
 5/2 2794/350 JAN 2 57 ✓ 2.600 MCF 6.  
 Co DIK 56 2774-35 24/  
 2718-24 N.S. 52/2693-2706 15  
 ga 2.641 MCF 72-20 ga 2.837  
 MCF 6 RP 415 #