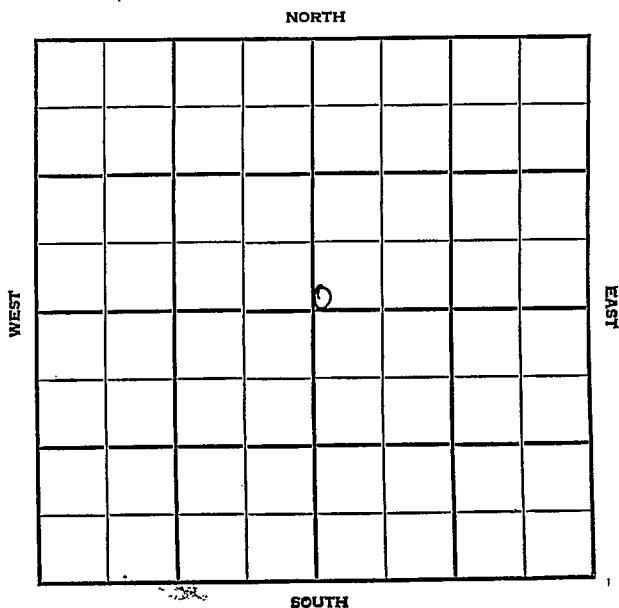


Section 22 Township 22 Range 33 WWell No. # 1 Walters UnitCompany Texas Co.

Finney KANSAS

SEC.	TWP.	R.
22	22	33W ✓

WELL NO.

1 Walters Unit

FARM

COMPANY

Texas Company

CONTRACTOR

Stickle Drlg.

_____ Ft. from N. Line


50

_____ Ft. from S. Line

_____ Ft. from E. Line

50

_____ Ft. from W. Line

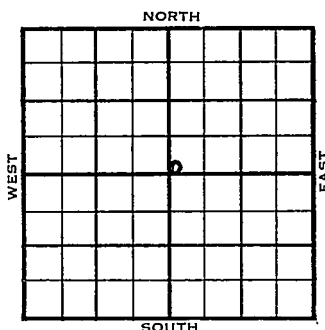

SW SW NE

1954	ELEVATION	REPORT
	2880'	

5/19

Spud 5-13-54

10" @ 312'

Drlg. 2465'

6/23

Spud 5-13-54 Gas well TD 2763'

10" @ 312 Her. 2523 TD 2763

7" @ 2762 CO to 2720 20/2640-50

500 A PB 2615 60/2580-90 500 A

103,000 gas 40/2526-36 44/2541-52

A-frac. Kri. 2539 Win. 2576

Ft. Riley 2637' PB 2570 40/2578-88

1000 A 1 1/2 MCFG 20 GWPD

Comp. 4,282,000 CFGPD 415#

COMPLETED

County Finney State Kansas

Sec. **22** (Blk.) **22** (Sur.) **33W** Map No.

Operator **Texas Company**

Well No. **1** Farm **Walters Unit**

Elev.	Location	SW	SW	NE
-------	----------	----	----	----

0.

FIRST REPORT

50 Ft. From S Line NE

50 Ft. From ~~IT~~ Line Quarter1st. Report **MAY 19 1954**

Completion.

Remarks


Stickle Drlg. - Contr.

Spudding Date **5-13-54**

Drlg. Data

10" @ 312 drlg. 2465

County Finney State Kansas
 Sec. 22 (Blk.) 22 (Sur.) 3 3W Map No. _____
 Operator Texas Company
 Well No. 1 Farm Walters Unit
 Elev. 2880 Location SW SW NE

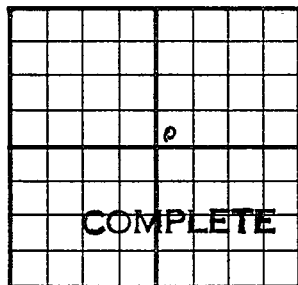

50 Ft. From S Line NE
 50 Ft. From W Line Quarter

1st. Report _____

Completion JUN 23 1954

Remarks _____

Stickle Drlg. - Contr.

Spudding Date 5-13-54

Drlg. Data Gas well TD 2763
10" @ 312 Her. 2523 TD 2763 7" @ 2762
CO to 2720 20/ 2640-50 500 A PB 2615
60/ 2580-90 500 A 103,000 gas
40/ 2526-36 44/ 2541-52 A-frac
Kri. 2539 Win. 2576 Ft. Riley 2637
PB 2570 40/ 2578-88 1000 A 1½ mcf/g
20 gwpd Comp. 4,282,000 of gpd 415%

J. G. McGEHEE