


Section 22 Township 22 Range 34-W

Well No. #1 Werner

Company Cities Service

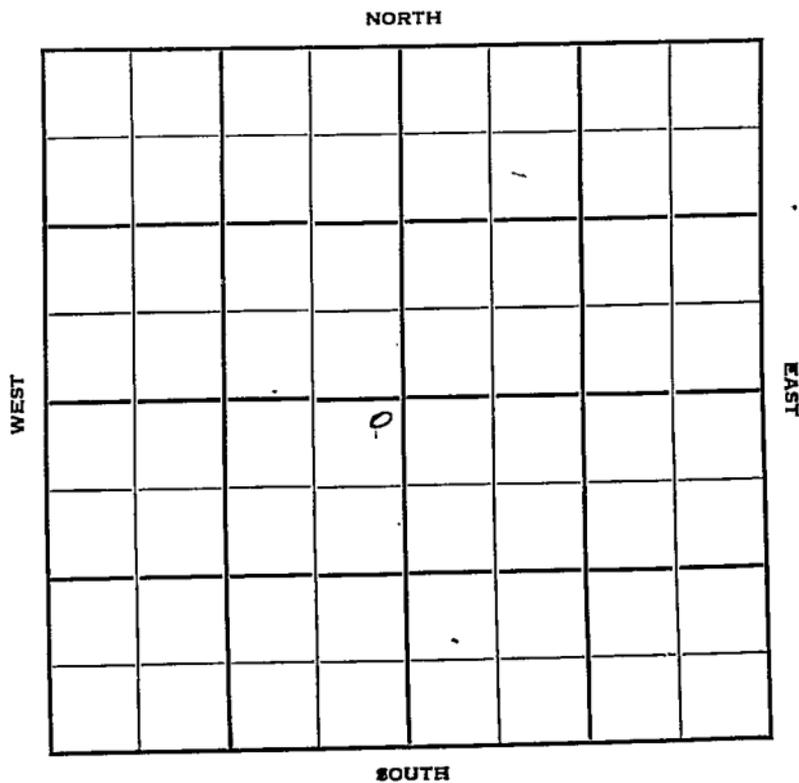

Sec. 22 Twp. 22 R. 34W-1

Well No. #1 Werner Farm

Cities Service Company

Contractor

Hugoton Pool


100' Ft. from N. Line

Ft. from S. Line

100' Ft. from E. Line

Ft. from W. Line

NE SW

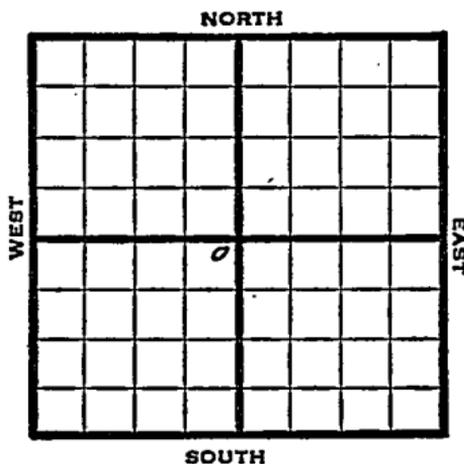

1950

Elev 2942'

REPORT

4/5

Location

5/31

8" @ 600

5" @ 2699

TD 2700

90/2636-56

30/2600-06

50/2584-90

50/2554-60

90/2530-48

40/2508-16

1700A

PB 2620

Hev 2507

Krider 2554

Winfield 2584

Ft Riley 2644

PB 2594

Comp 1,920,000 gas

**COMPLETED**

Kansas

Hugoton Pool

Map No. \_\_\_\_\_ Sec. 22 Twp. 22 R. 34W

Well No. 1 Werner

Cities Service \_\_\_\_\_ Company

\_\_\_\_\_  
Contractor

NE SW


## SECTION PLAT

100 Ft. from N. Line

\_\_\_\_\_ Ft. from S. Line

100 Ft. from E. Line

\_\_\_\_\_ Ft. from W. Line

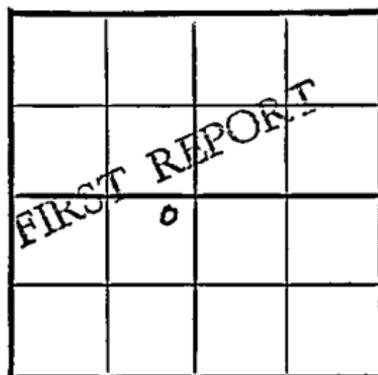

Finney County

Location X \_\_\_\_\_

Rig up \_\_\_\_\_

Drilling and Remarks: \_\_\_\_\_

## RECORD

Cased \_\_\_\_\_ in., \_\_\_\_\_ ft.

Sand \_\_\_\_\_

Gas \_\_\_\_\_

Oil \_\_\_\_\_

Total Depth \_\_\_\_\_

## PRODUCTION

1st 24 hrs. Nat. \_\_\_\_\_

1st 24 hrs. after shot \_\_\_\_\_

Gas \_\_\_\_\_ Cu. Ft.

Dry Hole \_\_\_\_\_

Abandoned \_\_\_\_\_

Date

APR 5 1950 19

J. E. TYRA

Scout

Map No. \_\_\_\_\_ Sec. 22 \_\_\_\_\_ Twp. 22 \_\_\_\_\_ R. 34W \_\_\_\_\_

Well No. 1 Werner

Cities Service \_\_\_\_\_ Company

\_\_\_\_\_ Contractor

NE SW

E1.2942  
SECTION PLAT

100 Ft. from N. Line

\_\_\_\_\_ Ft. from S. Line

100 Ft. from E. Line

\_\_\_\_\_ Ft. from W. Line

<b>COMPLETE</b>			
	o		

Finney

Location \_\_\_\_\_

Rig up \_\_\_\_\_

Drilling and Remarks:

8" @ 600  
 5" @ 2699  
 T.D. 2700  
 90/ 2636 - 56  
 30/ 2600 - 06  
 50/ 2584 - 90

**RECORD**

Cased \_\_\_\_\_ in., \_\_\_\_\_ ft.

Sand \_\_\_\_\_

Gas \_\_\_\_\_

Oil \_\_\_\_\_

Total Depth 2700

**PRODUCTION**

1st 24 hrs. Nat. \_\_\_\_\_

1st 24 hrs. after shot \_\_\_\_\_

Gas \_\_\_\_\_ Cu. Ft.

Dry Hole \_\_\_\_\_

Abandoned \_\_\_\_\_

Date

MAY 31 1950 19

**OVER**

J. E. TYRA Scout

50/ 2554 - 60

90/ 2530 - 48

40/ 2508 - 16

17000 A

PR 2620

Nov. 2507

Kriden 2554

Winfield 2584

77 Riley 2644

PR 2594

Comp. 1,920,000 gas

Misc.  
Pierce Map  
France Map  
Tracings  
Land Wall Map  
Land Small Map  
Scout Cards

5

W. M. S.










