12-22-23W

TYPE

AFFIDAVIT OF COMPLETION FORM

ACO-1 WELL HISTORY

SIDE ONE

State Geological Survey
WICHITA BRANCH

Compt.____

(Rules 82-3-130 and 82-3-107) DOCKET NO. NP_____

This form shall be filed with the Kansas Corporation Commission, 200 Colorado Derby Building, Wichita, Kansas 67202, within ninety (90) days after the completion of a well, regardless of how the well was completed.

FOR INFORMATION REGARDING THE NUMBER OF COPIES TO BE FILED AND APPLICATIONS REQUIRING COPIES OF ACO-1 FORMS SEE PAGE TWO (2), SIDE TWO (2) OF THIS FORM.

F ____ Letter requesting confidentiality attached.

C ✓ Attach ONE COPY of EACH wireline log run (i.e. electrical log, sonic log, gamma ray neutron log etc.)***Check here if NO logs were run_____.

PLEASE FILL IN ALL INFORMATION. IF NOT AVAILABLE, INDICATE. IF INFORMATION LATER BECOMES AVAILABLE, SUBMIT BY LETTER.

LICENSE # 6063 EXPIRATION DATE 6/84

OPERATOR Geodessa Corporation API NO. 15-083-21,107

ADDRESS 1125 - 17th St., Suite 2220 COUNTY Hodgeman

Denver, Colorado 80202 FIELD Hanston-Oppy

** CONTACT PERSON Ed Schuett PROD. FORMATION D&A

PHONE 303/296-1440 _____ Indicate if new pay.

PURCHASER N/A LEASE Neufelde "A"

ADDRESS _____ WELL NO. 1

WELL LOCATION 130' NW of CNWSE

DRILLING CONTRACTOR White & Ellis Drilling Co. 2070 Ft. from South Line and


ADDRESS Box 448 2070 Ft. from East Line of

El Dorado, Kansas 67042 the SE (Qtr.) SEC 12 TWP 22S RGE 23 (E) (W).

PLUGGING CONTRACTOR _____

ADDRESS Same

WELL PLAT

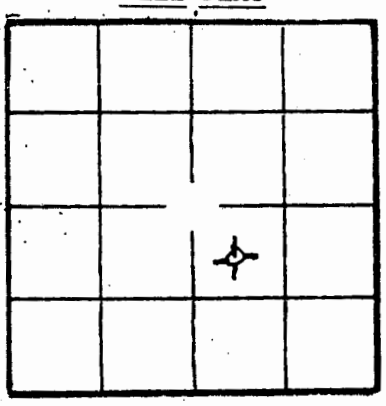

(Office Use Only)

KCC ✓

KGS ✓

SWD/REP__

PLG.____

NGPA____

TOTAL DEPTH 4570 PBTD _____

SPUD DATE 12-10-83 DATE COMPLETED 12-24-83

ELEV: GR 2305 DF _____ KB 2313

DRILLED WITH (CABLE) (ROTARY) (AIR) TOOLS.

DOCKET NO. OF DISPOSAL OR REPRESSURING WELL BEING USED TO DISPOSE OF WATER FROM THIS LEASE_____.

Amount of surface pipe set and cemented 336' DV Tool Used? No.

TYPE OF COMPLETION THIS AFFIDAVIT APPLIES TO: (Circle ONE) - Oil, Shut-in Gas, Gas, (Dry,) Disposal, Injection, Temporarily Abandoned. If OWWO, indicate type of re-completion _____. Other completion_____. NGPA filing_____.

ALL REQUIREMENTS OF THE STATUTES, RULES AND REGULATIONS PROMULGATED TO REGULATE THE OIL AND GAS INDUSTRY HAVE BEEN FULLY COMPLIED WITH.

A F F I D A V I T

E. C. Schuett, being of lawful age, hereby certifies that:

I am the Affiant, and I am familiar with the contents of the foregoing Affidavit.

WEL-22-21

ACO-1 Well History

Side TWO
OPERATOR Geodessa Corporation LEASE NAME Neufelde "A" SEC 12 TWP 22 S RGE 23 (E) (W)
WELL NO 1

FILL IN WELL INFORMATION AS REQUIRED:

Show all important zones of porosity and contents thereof; cored intervals, and all drill-stem tests, including depth interval tested, cushion used, time tool open, flowing and shut-in pressures, and recoveries.

Show Geological markers, logs run, or other Descriptive information.

Formation description, contents, etc.	Top	Bottom	Name	Depth
_____ Check if no Drill Stem Tests Run. _____ Check if samples sent Geological Survey. DST #1 4264-4306 - 30-60-30-60 Rec. 65' M IF 7171, ISIP 365, FF 81-81, FSIP 20 DST #2 4555-4570 - 30-60-60-60 Rec. 120' M & 120' thin watery mud IF 96-96, ISIP 1365, FF 135-145, FSIP 1218 (clock ran out during final SI) If additional space is needed use Page 2			Heebner Lansing B/Kansas City Marmaton Warsaw Osage	3870 3925 4289 4313 4544 4553

Report of all strings set — surface, intermediate, production, etc. CASING RECORD (New) or (Used)

Purpose of string	Size hole drilled	Size casing set (in O.D.)	Weight lbs/ft.	Setting depth	Type cement	Sacks	Type and percent additives
Surface		8-5/8		344	60-40-poz	200	3% CC, 2% gel

LINER RECORD			PERFORATION RECORD		
Top, ft.	Bottom, ft.	Sacks cement	Shots per ft.	Size & type	Depth interval

TUBING RECORD					
Size	Setting depth	Packer set at			

12-22-23W

State Geological Survey
WICHITA BRANCH

WHITE

AND ELLIS DRILLING, Inc.

DRILLERS LOG

OPERATOR: Geodessa Corp., 1125 17th Street - Suite 2220, Denver, Colorado. 80202

CONTRACTOR: White & Ellis Drilling, Inc., 401 E. Douglas, Suite 500, Wichita, Ks. 67202

Lease Name Newfelde "A" Well No. 1

Sec. 12 T. 22S R. 23W Spot C NW SE

County Hodgeman State Kansas Elevation

Casing Record:

Surface: 8 5/8" @ 344' with 200 sx. 3% CC 2% Gel

Production: @ with sx.

Type Well: D & A Total Depth 4570'

Drilling Commenced 12-15-83 Drilling Completed 12-25-83

Formation	From	To	Tops
Cellar	0	7	
Shale	7	587	
Shale, Lime	587	4480	
Lime	4480	4570	