

JUN 29 1984

STATE CORPORATION COMMISSION OF KANSAS
OIL & GAS CONSERVATION DIVISIONALL COMPLETION OR RECOMPLETION FORM
ACO-1 WELL HISTORY

DESCRIPTION OF WELL AND LEASE

Operator: license # 8890
 name Donald J. Malone, Geologist
 address 919 Century Plaza
 111 W. Douglas
 City/State/Zip Wichita, Kansas 67202

Operator Contact Person Don Malone
 Phone 316.263-4225

Contractor: license # 5137
 name J-W Drilling

Site Geologist Don Malone
 Phone 316.263-4225

Well Type of Completion

☐ New Well ☐ Re-Entry ☐ Workover

Oil ☐ SWD ☐ Temp Abd
 Gas ☐ Inj ☐ Delayed Comp.
 Other ☐ Other (Core, Water Supply etc.)

JWWO: old well info as follows:

Operator
 Well Name
 Comp. Date Old Total Depth

WELL HISTORY

Drilling Method: ☒ Mud Rotary ☐ Air Rotary ☐ Cable

6-12-84... 6-19-84... 6-20-84...
 Date Date Reached TD Completion Date

4695 KB... NA...
 Total Depth PBTD

of Surface Pipe Set and Cemented at 8.5/8 @ 260! feet

Multiple Stage Cementing Collar Used? ☐ Yes ☒ No

If Yes, Show Depth Set feet

Alternate 2 completion, cement circulated
 from 253 feet depth to Surface w/ 200 SX cmt

API NO. 15 - 083-21,144

County Hodgeman

State Geological Survey
WICHITA BRANCH

C SE SE Sec 18 Twp 22S Rge 23
 (location) ☐ East ☒ West

660 Ft North from Southeast Corner of Section

660 Ft West from Southeast Corner of Section

(Note: locate well in section plat below)


Lease Name Bradshaw Well# 1

Field Name Wildcat

Producing Formation NA

Elevation: Ground 2361 KB 2366

Section Plat

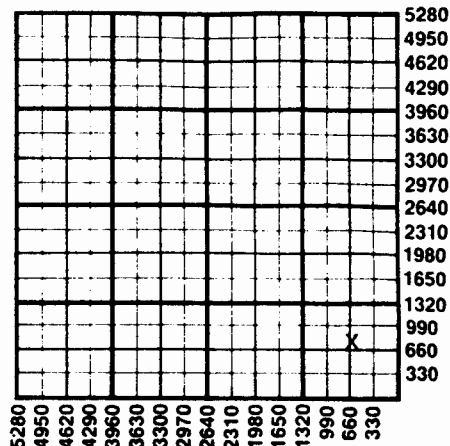

WATER SUPPLY INFORMATION

Source of Water:

Division of Water Resources Permit # NA

☐ Groundwater... NA Ft North From Southeast Corner and
 (Well) ... NA Ft. West From Southeast Corner of
 Sec Twp Rge ☐ East ☐ West

☒ Surface Water... NA Ft North From Southeast Corner and
 (Stream, Pond etc.) ... Pond Ft West From Southeast Corner
 Sec 32 Twp 21 Rge 23 ☐ East ☒ West

☐ Other (explain)

(purchased from city, R.W.D.#)

Disposition of Produced Water: ☐ Disposal
☐ Repressuring

Docket #

INSTRUCTIONS: This form shall be completed in duplicate and filed with the Kansas Corporation Commission, 200 Colorado Derby Building, Wichita, Kansas 67202, within 90 days after completion or recompletion of any well. Rules 82-3-130 and 82-3-107 apply.

Information on side two of this form will be held confidential for a period of 12 months if requested in writing and submitted with the form. See rule 82-3-107 for confidentiality in excess of 12 months.

All wireline logs and drillers time log shall be attached with this form. Submit CP-111 form with all plugged wells. Submit CP-111 form with abandoned wells.

RECEIVED

STATE CORPORATION COMMISSION

JUN 06 1984

☐ East
☒ West

INSTRUCTIONS: Show important tops and base of formations penetrated. Detail all cores. Report all drill stem tests giving interval tested, time tool open and closed, flowing and shut-in pressures, whether shut-in pressure reached static level, hydrostatic pressures, bottom hole temperature, fluid recovery, and flow rates if gas to surface during test. Attach extra sheet if more space is needed. Attach copy of log.

☒ Yes	☐ No
☒ Yes	☐ No
☐ Yes	☒ No

☒ Log ☐ Sample

Name	Top	Bottom
Anhydrite	1617	1647
Heebner	3920	3926
Lansing	3970	
B/KC		4375
Ft Scott	4534	4562
Miss Warsaw	4646	4684
Miss Osage	4684	quit

DST No. 1 4599-4651 (Western)

Op 30 SI 30 Op 30 SI 30

Rec 30' mud

IFP 50-50 IHP 2396

ISIP 81# FHP 2336

FFP 50-50

FSIP 71#

123° F

JUN 29 1984

State Geological Survey
WICHITA BRANCH

☐ new ☐ used

Report all strings set - conductor, surface, intermediate, production, etc.

[illegible]

PERFORATION RECORD

shots per foot | specify footage of each interval perforated

Acid, Fracture, Shot, Cement Squeeze Record

(amount and kind of material used)

Depth