

9
SIDE ONE

STATE CORPORATION COMMISSION OF KANSAS
OIL & GAS CONSERVATION DIVISION
WELL COMPLETION FORM
ACO-1 WELL HISTORY
DESCRIPTION OF WELL AND LEASE

Operator: License # 4767
Name: Ritchie Exploration, Inc.
Address 125 N. Market, Suite 1000

City/State/Zip Wichita, KS 67202
Purchaser: Koch Oil Co.
Operator Contact Person: Jeff Christian
Phone (316) 267-4375

Contractor: Name: Murfin Drilling Co.
License: 6033
Wellsite Geologist: Bob Mathiesen

Designate Type of Completion

☒ New Well ☐ Re-Entry ☐ Workover

☒ Oil ☐ SWD ☐ Temp. Abd. ☐ Temp. Abd. ☐ Temp. Abd.
☐ Gas ☐ Inj ☐ Delayed Completion
☐ Dry ☐ Other (Core, Water Supply, etc.)

If **OWMO**: old well info as follows:


Operator:
Well Name:
Comp. Date Old Total Depth

Drilling Method:

☒ Mud Rotary ☐ Air Rotary ☐ Cable

5/24/89 6/01/89 6/19/89
Spud Date Date Reached TD Completion Date

API NO. 15- 083-21,324
County Hodgeman
C SE NW Sec. 28 Twp. 22S Rge. 23 ☒ East ☐ West
3300 Ft. North from Southeast Corner of Section
3300 Ft. West from Southeast Corner of Section
(NOTE: Locate well in section plat below.)
Lease Name Darlene Smith Well # 1
Field Name wildcat
Producing Formation Mississippian Osage
Elevation: Ground 2314' KB 2319'
Total Depth 4683' PBDT n/a

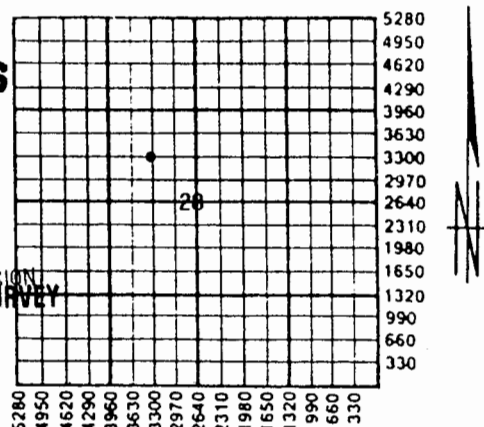

PLEASE KEEP THIS
INFORMATION
CONFIDENTIAL

RECEIVED

KANSAS GEOLOGICAL SURVEY
WICHITA BRANCH
SEP 22 1989

CONSERVATION DIVISION
Wichita, Kansas
SEP 26 1989

Amount of Surface Pipe Set and Cemented at 421 Feet
Multiple Stage Cementing Collar Used? ☒ Yes ☐ No
If yes, show depth set 1547 Feet
If Alternate II completion, cement circulated from 1547
feet depth to 430 w/ 350 sx cmt.

INSTRUCTIONS: This form shall be completed in triplicate and filed with the Kansas Corporation Commission, 200 Colorado Derby Building, Wichita, Kansas 67202, within 120 days of the spud date of any well. Rule 82-3-130, 82-3-107 and 82-3-106 apply. Information on side two of this form will be held confidential for a period of 12 months if requested in writing and submitted with the form. See rule 82-3-107 for confidentiality in excess of 12 months. One copy of all wireline logs and drillers time log shall be attached with this form. ALL CEMENTING TICKETS MUST BE ATTACHED. Submit CP-4 form with all plugged wells. Submit CP-111 form with all temporarily abandoned wells. Any recompletion, workover or conversion of a well requires filing of ACO-2 within 120 days from commencement date of such work.

All requirements of the statutes, rules and regulations promulgated to regulate the oil and gas industry have been fully complied with and the statements herein are complete and correct to the best of my knowledge.


Signature [Signature]

Title Vice President Date 9/19/89

Subscribed and sworn to before me this 19th day of September, 19 89.

Notary Public Linda K. Rice

Date Commission Expires 6/07/92

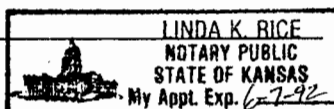

K.C.C. OFFICE USE ONLY		
☒ F	Letter of Confidentiality Attached	
☒ W	Wireline Log Received	
☒ C	Drillers Timelog Received	
Distribution		
☒ KCC	☐ SWD/Rep	☐ NGPA
☒ KGS	☐ Plug	☐ Other
(Specify)		