

Section 23 Township 22 Range 11WWell No. #1 GeorgeCompany Burwick Drlg.

NORTH

|  |  |   |  |  |  |  |  |
|--|--|---|--|--|--|--|--|
|  |  |   |  |  |  |  |  |
|  |  |   |  |  |  |  |  |
|  |  | 0 |  |  |  |  |  |
|  |  |   |  |  |  |  |  |
|  |  |   |  |  |  |  |  |
|  |  |   |  |  |  |  |  |
|  |  |   |  |  |  |  |  |
|  |  |   |  |  |  |  |  |

WEST

EAST

SOUTH

Stafford

KANSAS

Sec. 23 Twp. 22 R. 14 W

Well No. # 1 <sup>HoFF</sup> George Farm

Burwick Drlg. Company

Burwick Contractor


Oscar Pool

990 Ft. from N. Line

990 Ft. from S. Line

990 Ft. from E. Line

           Ft. from W. Line

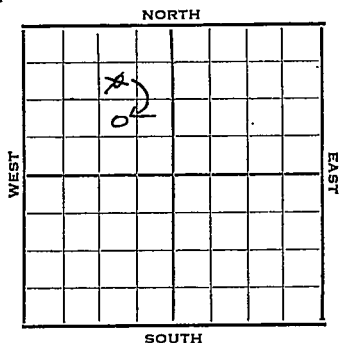

1951 Elev. 1930' REPORT

11/28 RUR

1952

2/6

Spud 11-20-51

Oil Well TD 3785

8" @ 340

Anhy 835 Heeb. 3337

Br lime 3466 Lañs. 3478

DST 3608-38 opn 1 hr

Rec. 10' socm

DST 3675-85 opn 90 min.


Rec. 20' mco Viola 3777

5" @ 3778 TD 3785 10 goph

Hydra S/50 bo 10 hr. Comp. 7 bopd

**COMPLETED**

County Stafford State Kansas  
 Sec. 23 (Blk. Twp.) 22 (Sur. Rge.) 14W Map No. \_\_\_\_\_  
 Operator Burwick Drlg.  
 Well No. 1 Farm George  
 Elev. \_\_\_\_\_ Location SW NE NW

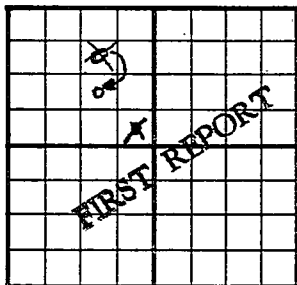

390 Ft. From SW Line NW

390 Ft. From E Line Quarter

1st. Report NOV 28 1951

Completion

Remarks

Burwick - Contr.

Spudding Date

Drlg. Data

Oscar Pool

RUR

J. E. TYRA

Kansas

Map No. \_\_\_\_\_ Sec. 23 Twp. 22 R. 14WWell No. 1 Hoff

Burwick Drlg. \_\_\_\_\_ Company \_\_\_\_\_

**CORRECTION**

Contractor \_\_\_\_\_

NW SE NW

## SECTION PLAT

\_\_\_\_\_ Ft. from N. Line

990 Ft. from S. Line990 Ft. from E. Line

\_\_\_\_\_ Ft. from W. Line

|  |   |  |  |
|--|---|--|--|
|  |   |  |  |
|  | 0 |  |  |
|  |   |  |  |
|  |   |  |  |
|  |   |  |  |

Stafford County

Location \_\_\_\_\_

Rig up \_\_\_\_\_

Drilling and Remarks:

Reconnected from

#1. George

SW NE NW

## RECORD

Cased \_\_\_\_\_ in., \_\_\_\_\_ ft.

Sand \_\_\_\_\_

Gas \_\_\_\_\_

Oil \_\_\_\_\_

Total Depth \_\_\_\_\_

## PRODUCTION

1st 24 hrs. Nat. \_\_\_\_\_

1st 24 hrs. after shot \_\_\_\_\_

Gas \_\_\_\_\_ Cu. Ft.

Dry Hole \_\_\_\_\_


Abandoned \_\_\_\_\_

Date

NOV 28 19

J. E. TYRA Scout

County Stafford State Kansas  
 Sec. 23 (Blk. Twp.) 22 (Sur. Rge.) 14W Map No. \_\_\_\_\_  
 Operator Burwick Drlg.  
 Well No. 1 Farm Hoff  
 Elev. 1930 Location NW SE NW

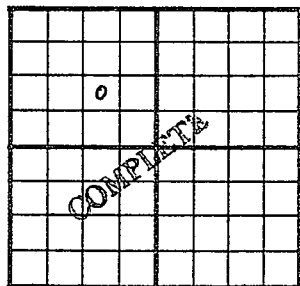

990 Ft. From S Line NW  
 990 Ft. From E Line Quarter

1st. Report \_\_\_\_\_

Completion FEB 6 1952

Remarks Oscar Pool

Burwick - Contr.

Spudding Date 11-20-51

Drlg. Data Oil well TD 3785

8" @ 340 Anhy 835 Heeb. 3337

Br. line 3466 Lans. 3478 DST 3608-38

open 1 hr. Rec. 10' socm DST 3675-85

open 90 min. Rec. 20' mco Viola 3777

5" @ 3778 TD 3785 10 goph Hydro.

S/ 50 bo 10 hr. Comp. 7 bopd

J. G. McGEHEE