


KANSAS

Stafford

Section 23 Township 22 Range 14-W

Well No. #1 Staff

Company Phillips
Hart Pool

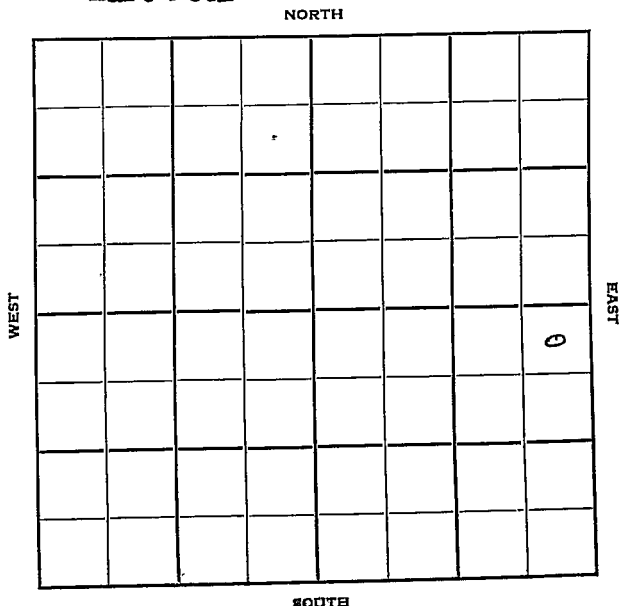

Stafford

KANSAS

Sec. 23 Twp. 22 R. 14W ✓

Well No. #1 Staff Farm _____

Phillips

Company _____

Hart Pool


330' Ft. from N. Line

_____ Ft. from S. Line

330' Ft. from E. Line

_____ Ft. from W. Line

NE SE

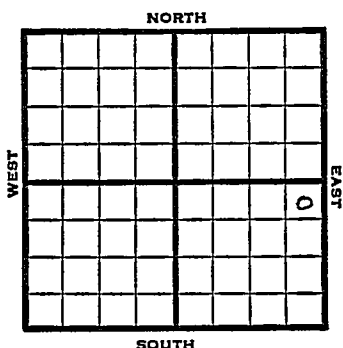

1949

Elev 1931'

R E P O R T

11/30

Location

12/7

"

12/14

8" @ 434'

Drlg. 2063'

12/21

Lansing 3452'

Drlg 3640'

12/28

Arb 3806-12'

TD 3812'

Run csg.

1950

2/1

TD 3812'

8" @ 434'

5" @ 3807'

Heeb 3306'

Lans 3452'

Simp 3745'

Arb. 3806'

P 565 BOPD

Comp

COMPLETED

Map No. _____ Sec. 23 Twp. 22 R. 14W

Well No. 1 Staff

Phillips Company

Contractor

NE SE


FIRST REPORT SECTION PLAT

330 Ft. from N. Line

_____ Ft. from S. Line

330 Ft. from E. Line

_____ Ft. from W. Line

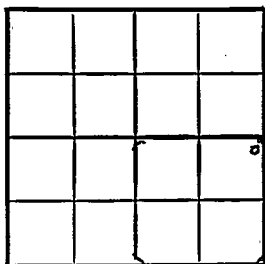

Stafford County

Location X

Rig up _____

Drilling and Remarks:

RECORD

Cased _____ in., _____ ft.

Sand _____

Gas _____

Oil _____

Total Depth _____

PRODUCTION

1st 24 hrs. Nat. _____

1st 24 hrs. after shot _____

Gas _____ Cu. Ft.

Dry Hole _____

Abandoned _____

Date

NOV 30 1949

19

S. J. LEWIS

Scout

Kansas

Hart Pool

Map No. _____ Sec. 23 Twp. 22 R. 14WWell No. 1 Staff

_____ Phillips _____ Company

_____ Contractor


NE SE

E. 1931
SECTION PLAT330 Ft. from N. Line

_____ Ft. from S. Line

330 Ft. from E. Line

_____ Ft. from W. Line

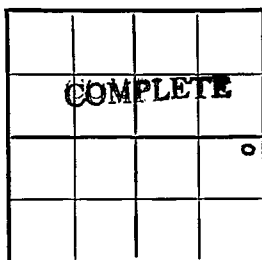

Stafford County

Location _____

Rig up _____

Drilling and Remarks: _____

*8' @ 434.**5" @ 3807**Keel 3306**Lane 3452**Simp 3745**and 3806**565 BOPD*

RECORD

Cased _____ in., _____ ft.

Sand _____

Gas _____

Oil _____

Total Depth 3812

PRODUCTION

1st 24 hrs. Nat. _____

1st 24 hrs. after shot. _____

Gas _____ Cu. Ft.

Dry Hole _____

Abandoned _____

Date

F
FEB 1 1950

J. E. TYRA

19

Scout

~~W.P.~~

County Stafford Elev. 1391
 Sec. 23 Twp. (22) Rge. 14W
 Company Phillips
 FarmName Staff No. 1

TOPS	DEPTH	LOG	DATUM	Loc. in Sec.
Anh.				NE NE SE
Tr.				OWPB
H.				OWPB
Tr.				
Dg.				
BL.				
L.	3452			Geol.
K.C.				Contr.
B.K.C.				
Ce.				
C.				
M.				Pool
M.				
K.				
Mz.				
Mo.				
V.				
S.				
S.	3806			
A.				
R.				
PE.				
G.				
T.D.				

FIRST REPORT
 JAN 30 '57
 COMPLETE

Date Comm.

OTD 3812 5" @ 3807 32/ 3627-35
 B/ 3 $\frac{1}{2}$ go 3 hr. 500 A S/ 1.17 bo 1 hr.
 PB 3620 48/ 3601-13 S/ 1.28 bo 3 hr.
 500 A S/ 67.86 bw 6 hr. 500 A
 S/ 45 bw 4 hr. CO 3600 PB 3574
 141/ 3513-24 500 A S/ 2.29 bo
 8.80 bw 7 hr. 1500 A S/ 2.92 bo
 3 bw 6 hr. CO 3689 S/ 16.42 bo
 13.91 bw 8 hr. PB 3498

16/ 3484-92 500A S/ 6.82 bo
43 bw 15 hr. CO 3689 S/ 4.70 bo
7.58 bw 3 hr. P/ 24 bo 5 bw 24 hr.
Comp. 13 hpd 30 bw