


Section 23 Township 22 Range 6W ^{KANSAS}

Well No. #1 Phillips

Company Penquin Petroleum Company

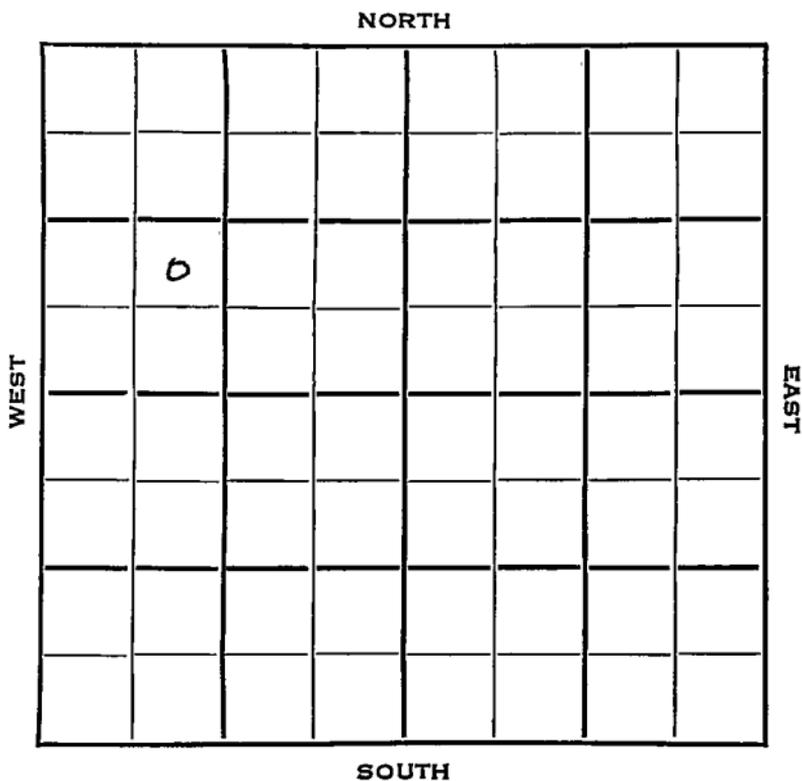

Sec. 23 Twp. 22 R. 6 W

Well No. # 1 Phillips Farm

Penquin Pet. Company

Lindsley Drlg. Contractor

Wildcat


_____ Ft. from N. Line

990 Ft. from S. Line

_____ Ft. from E. Line

990 Ft. from W. Line

NE SW NW

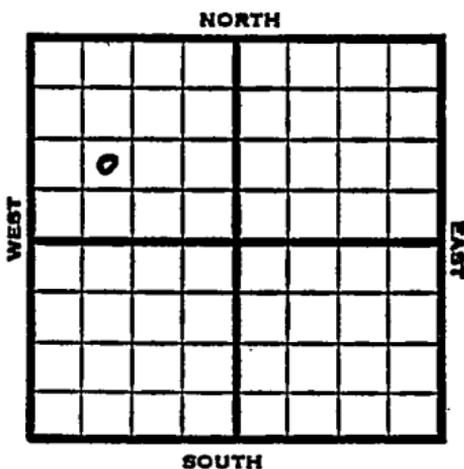

1953

Elev. 1562' REPORT

3/25
4/2

Location
Anhy 125
10" @ 125
Drlg 2580

4/9

Lans 2853, KH 3653
Drlg. 4011'

4/15

~ pud 3-26-53
D&A
TD 4022
Anhy 125,
10" @ 125
Lans 2853, Kh. 3653, Miss 3511,
Viola 3948, Simp 3973
TD 4022
D&A

ABANDONED

