


Map No. ~~21~~ ²³ Sec. ²³ Twp. ²² R. ^{2^w}

Well No. 1- Spurling Farm
Sudray Oil Company

NORTH

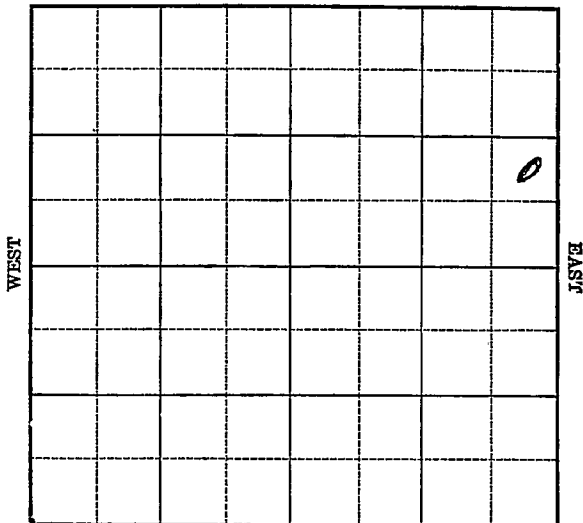

SOUTH

Location _____

Drilling Remarks _____

Rig Up _____

Drilling Remarks _____

RECORD

Cased _____ in. _____ ft.

Sand _____

Gas _____

Oil _____

Total Depth _____

PRODUCTION

1st 24 hrs. Nat. _____

1st 24 hrs. after shot _____

Gas _____ cu. ft.

Dry Hole _____


Abandoned _____

Harvey
2nd

Map No. KANSAS Sec. 23 Twp. 22 R. 2

Well No. 1 - Sperling Farm
Sunray Oil Company

 Ft. from N. Line
990 Ft. from S. Line
330 Ft. from E. Line
 Ft. from W. Line

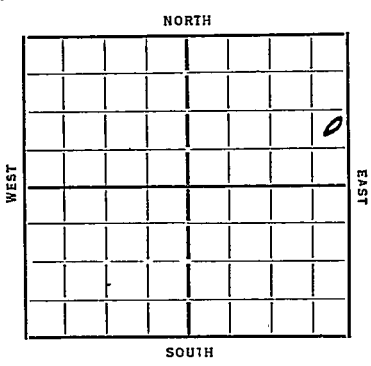

Date	REPORT
5/1	Cellar
5/9	BR
5/16	Rgn
5/23	Qty 560 12" 171
5/29	" 2245
6/6	KC 2333 Chat 2949
6/13	Qty 3022 80 3278 B.L. 3279 Miscellaneous 3289 3290 T7 Rust
6/20	Bailing
6/28	6" 3403 T7 CO.
7/3	Simp 3440 Wx 3447 T7 3463 Oil 3458-61 Shot 70 gts Sivab 115 Bbls 18 hrs.
7/14	CO to tube
7/17	Wilcox 3447 T7 3463 70 gts 81 Bbls.

COMPLETED

Map No. 43 Sec. 23 Twp. 22 R. 2 W

Well No. 1 - Spurling

Sunray oil Company

Contractor

FIRST REPORTS

SECTION PLAT

..... Ft. from N. Line

990 Ft. from S. Line

330 Ft. from E. Line

..... Ft. from W. Line

			0

Location.....

Rig up.....

Drilling and Remarks:

clean

RECORD

Cased..... in., ft.

Sand.....

Gas.....

Oil.....

Total Depth.....

PRODUCTION

1st 24 hrs. Nat.....

1st 24 hrs. after shot.....

Gas..... Cu. Ft.

Dry Hole.....

Abandoned.....

Date

5-1-35 192.....

ORVAL MANNSCHRECK

Scout

Map No. 43 Sec. 23 Twp. 22 R. 2W

Well No. Spurling

Sumray et al Company

Contractor

COMPLETED

SECTION PLAT

			0

Ft. from N. Line

990 Ft. from S. Line

330 Ft. from E. Line

Ft. from W. Line

Location

Rig up

Drilling and Remarks:

70 gto

81 bbls

RECORD

Cased _____ in., _____ ft.

Sand Wilson 3447

Gas _____

Oil _____

Total Depth 3463

PRODUCTION

1st 24 hrs. Nat. _____

1st 24 hrs. after shot _____

Gas _____ Cu. Ft.

Dry Hole _____

Abandoned _____

Date

7-17-35 192

ORVAL MANSO

Scout