



DX 78-1

Section 23 Township 22 Range 2W

Well No. 1 Sperling

Company Wilson & Siegrist

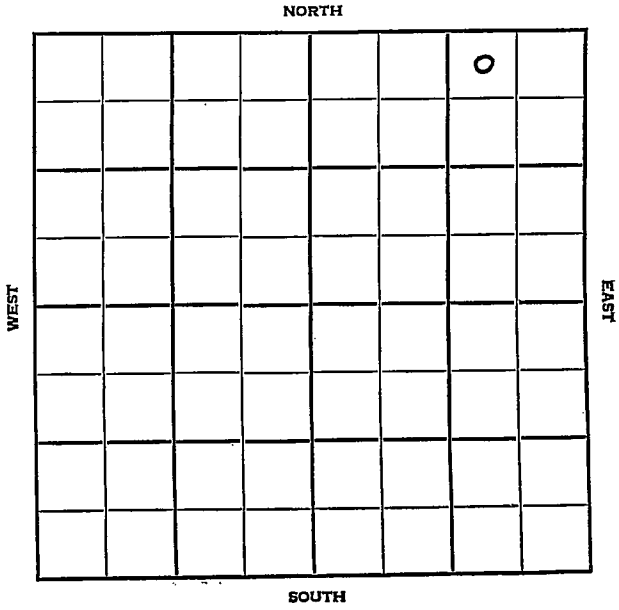

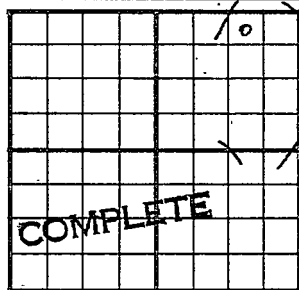County Harvey State KansasSec. 23 (Blk. Twp.) 22 (Sur. Rge.) 2W Map No.Operator Wilson & SiegristWell No. 1 Farm SperlingElev. 1466 Location NW NE NE330 Ft. From N Line NE990 Ft. From E Line Quarter

1st. Report

Completion AUG 4 1954Remarks Sperling PoolStearns - Contr.Spudding Date 6-17--54Drlg. Data Oil well TD 32788" @ 157 Lans. 2318 B KC 2673Miss. 2917 Hunton 3241 DST 3244-78open 1 hr. Rec. 125^f ocm 795#5" @ 3241 CO to 3278 2 $\frac{1}{2}$ bophP/ 30 bopd 300 A Comp. 40 bopd