


Harvey
22 2w

Map No. KANSAS Sec. 23 Twp. 22 R. 2w

Well No. 2- Spurling Farm _____
Imo Oil Company _____

330 Ft. from N. Line
____ Ft. from S. Line
330 Ft. from E. Line
____ Ft. from W. Line
Elev. 1469

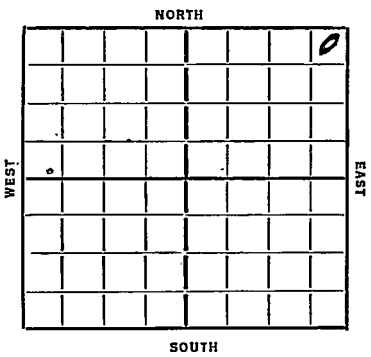

Date	REPORT	O. W. D. D
1935		
10/30	Log	
11/7	75 ft	
11/14	—	
11/21	Rw	
11/29	Spud	
12/6	15" 175	12" 1050
12/13	12" 1360	12" 1360
12/19	" 1873	
12/26	—	
1/2/36	12" 2420	
1/19	" 2775	8" 2641
1/17	" 2960	6" 2937
1/22	Chat 2935	
	TD 2980	
	S, 200,000 Gas	
	COMPLETED	
	OVER	

1938

O. W. D. D

5/4

Old T.D. 2980'.

Hunton 3278'.

T.D. 3318'.

200' Fluid 12 hrs.

35% water.

FIRST REPORT

and

ABANDONED

KANSAS

Map No. 43 Sec. 23 Twp. 22 R. 2W

Well No. 2-Sperling

2mo oil Company

Contractor

FIRST REPORTS

SECTION PLAT

330 Ft. from N. Line

..... Ft. from S. Line

330 Ft. from E. Line

..... Ft. from W. Line

			0

Location.....

Rig up.....

Drilling and Remarks:

Log

RECORD

Cased.....in.,ft.

Sand.....

Gas.....

Oil.....

Total Depth.....

PRODUCTION

1st 24 hrs. Nat.....

1st 24 hrs. after shot.....

Gas.....Cu. Ft.

Dry Hole.....

Abandoned.....

Date

10-30-35 192.....

WAL MANNSCHECK

Scout

Map No. 43 Sec. 23 Twp. 22 R. 2W

Well No. 2 - Sperry

Ino Oil Company

Contractor

SECTION PLAT

330 Ft. from N. Line

..... Ft. from S. Line

330 Ft. from E. Line

..... Ft. from W. Line

			0

COMPLETED

RECORD

Location.....

Cased..... in., ft.

Rig up.....

Sand Chat 2935

Drilling and Remarks:

Gas.....

Oil.....

Total Depth 2980

5,200,000 gas

PRODUCTION

1st 24 hrs. Nat.....

1st 24 hrs. after shot.....

Gas..... Cu. Ft.

Dry Hole.....

Abandoned.....

Date JAN 22 1936

.....192..... Scout

ORVAL MANN SCHRECK

Map No. 43 Sec. 23 Twp. 22 R. 2WWell No. 2 Sperling

Imo

Company

FIRST REPORT

Contractor

COMPLETED

NE/C

SECTION PLAT

			0

330 Ft. from N. Line

_____ Ft. from S. Line

330 Ft. from E. Line

_____ Ft. from W. Line

Location _____

Rig up _____

Drilling and Remarks:

OWDD-OTD 2980

Hunton 3278

TD 3318

200^r Fluid 12hrs.

35% Water

D & A

RECORD

Cased _____ in., _____ ft.

Sand _____

Gas _____

Oil _____

Total Depth _____

PRODUCTION

1st 24 hrs. Nat. _____

1st 24 hrs. after shot _____

Gas _____ Cu. Ft.

Dry Hole _____

Abandoned _____

Date

MAY 4 - 1938 19 _____ H. D. Hatfield Scout