


Finney

KANSASSECTION 23 TOWNSHIP 22 RANGE 33 WWELL NO. #1 Finnup Gas UnitCOMPANY Petroleum Inc.

NORTH

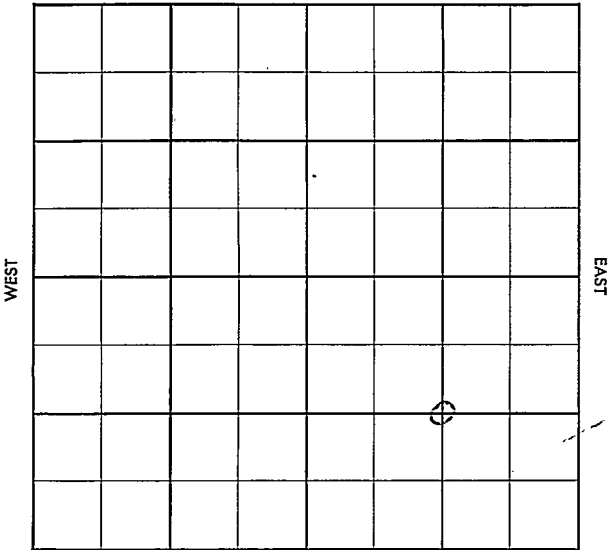

SOUTH

Finney

KANSAS

SEC.	TWP.	R.
23	22	33W

WELL NO.

#1 Finnup Gas Unit

FARM

COMPANY

Petroleum Inc.

CONTRACTOR

Rocket Drlg.

Hugoton


Ft. from N. Line

Ft. from S. Line

Ft. from E. Line

Ft. from W. Line

C SE/4

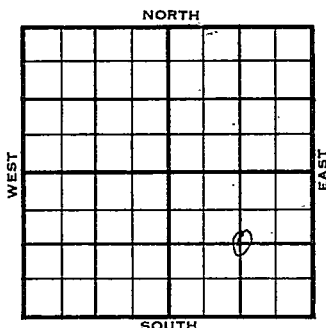

NCRA - FO

	ELEVATION	REPORT
1955	2881 RB, 2879 DF	
12-14	Comm. 12-3-55 8" @ 262/175 5" @ 2634/650 MICT Heñr. 2579 Kri 2602 B. Kri 2618 Win. 2632 TD 2635	
1956		
1-11	CO to 2629 DD 2637 DD 2639 50 mcfg DD 2641, 75 mcfg, 1000 A, 1 mcfg PB 48/ 2582-94, 100 mcfg 56/ 2602-16, 235 mcfg, frac, 3000 A 12½ mmcf CO to 2641, 1000 A 4½ hrs., BD 11, 165 mcfg Comp. 12,200 mcfgpd, 432# ## TD 2641'	

COMPLETED

County Finney Elev. 2881 RBSec. 23 Twp. 22 Rge. 33WCompany Petroleum Inc.FarmName Finnup Gas Unit No. 1

TOPS	DEPTH	LOG	DATUM
Anh.			
Tr.			
H.			
Tr.			
Dg.			
BL.			
L.			
K.C.			
B.K.C.			
Ce.			
C.			
M.			
M.			
K.			
Mz.			
Ma.			
V.			
S.			
S.			
A.			
R.			
Pe.			
G.			
T.D.			

herr.
 Kri.
 B. Kri.
 Win.

2579
 2602
 2618
 2632

Loc. in Sec.

C SE/4

Geol.

Contr.

Rocket Drlg.

Pool

Rugoton

FIRST REPORT

DEC 14

Date Comm. 12-3-55 NCRA - FG

8" @ 262/175 5" @ 2634/650 HIGT

55

2879 DF

County Finnery Elev. 2881 RBSec. 23 Twp. 22 Rge. 33WCompany Petroleum Inc.Farm Name Finnup Gas Unit No. 1

TOPS	DEPTH	LOG	DATUM
Anh.			
Tr.			
H. <u>1/2</u>		<u>2579</u>	
Tr. <u>1/2</u>		<u>2612</u>	
Dg. <u>1/2</u>		<u>2618</u>	
BL. <u>1/2</u>		<u>2632</u>	
L.			
K.C.			
B.K.C.			
Ce.			
C.			
M.			
M.			
K.			
Mz.			
Mq.			
V.			
S.			
S.			
A.			
R.			
Pf.			
G.			
T.D.		<u>2635</u>	

Loc. in Sec. C SE/4

Geol.

Contr.

Rocket Drlg.

Pool

Hugoton

COMPLETE

Date Comm. 12-3-55 JAN 11 1956

8" @ 262/175 5" @ 2634/650

CO to 2629 DD 2637 DD 2639

50 mcf/g DD 2641 75 mcf/g 1000 A

1 mcf/g PB 48/ 2582-94 100 mcf/g

56/ 2602-16 235 mcf/g frac 3000 A

12 $\frac{1}{2}$ mmcf/g CO to 2641 1000 A4 $\frac{1}{2}$ hr. BD 11,165 mcf/g

Comp. 12,200 mcf/gpd 432#