

Section 23 Township 22 Range 37W

Well No. v #1 Miller (C)

Company Trans-Era Pet Corp & Nate Appleman

NORTH

							0

WEST

EAST

SOUTH

Sec. 23 Twp. 22 R. 37WWell No. #1 Miller (G) Farm

Trans-Era Pet. Corp & Nate Appleman Company

Contractor

Wildcat.


330 Ft. from N. Line

Ft. from S. Line

330 Ft. from E. Line

Ft. from W. Line

NE NE NE

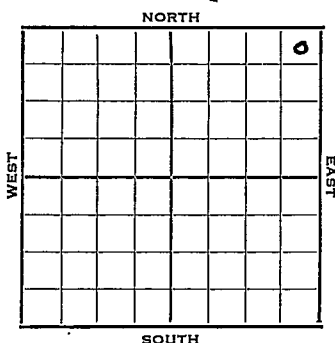

1953 Elev. 3264' REPORT

7/8 MIRT

7/22 8" @ 238'

Her 2587, Kr. 2604

DST 2606-28 1 hr, 30' M, 105#

Win 2639, Tow 2685, Ft. Riley 2741,

Lans 3940

DST 4146-58 1 hr, & 20 mins, 325' M & SW, 1030#

Drlg 4208'

7/29 DST 3957-4007', 1 hr, 390' W 1050#

DST 4212-45, 1 hr, 2200' W 1050#

DST 4796-4944, 1 hr, 8' M

Drlg. 4944' Cherokee 4560'

8/5 Miss 4971

RTD 5180'

5" @ 4835'

8/12 Spud 7-7-53

D & A

TD 5180'

8" @ 238'

Her. 2587, Kri 2604,

DST 2606-28 opn 1 hr, rec 30' mud

105# Win 2639, Tow 2685, Ft. Riley

2741, Lans 3940

DST 4146-58 opn 1 hr 20 min rec 325' m
mud & sw, 1030#

DST 3927-4007 opn 1 hr, rec 390' wtr.

OVER

1953

Information brought forward.

8/12

1050#

DST 4212-45 opn 1 hr, rec 2200' wtr.
1050#

DST 4796-4944' opn 1hr, rec 8' mud,
Cherokee 4560, Miss 4971,
TD 5180'

5 " @ 4835'

DST 5055-5180 opn 1 hr, rec 1144' wtr
CO to 2810'

10/ 2800-05 500 A 10/ 2686-96

500 A 20/ 2686-96 500 A


16/ 2648-56

D & A

ABANDONED

J. G. McGEHEE

County Kearny State Kansas
 Sec. 23 (Blk. 22 (Sur. 37W Map No. 22 (Twp. 37W Rge. 22)
 Operator Trans-Era Pet. & Nate Appleman
 Well No. 1 Farm Miller "C"
 Elev. 3264 Location NE NE NE

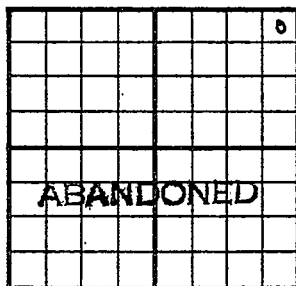

330 Ft. From N Line NE
330 Ft. From E Line Quarter

1st. Report

Completion AUG 12 1953

Remarks Wildcat

Spudding Date 7-7-53

Drilg. Data D & A TD 5180

8" @ 238 Her. 2587 Kri. 2604

DST 2606-28 open 1 hr. Rec. 30' mud

105# Win. 2639 Tow. 2685 Ft. Riley 2741

Lans. 3940 DST 4146-58 open 1 hr. 20 min.

Rec. 325' mud & sw 1030# DST 3927-4007

open 1 hr. Rec. 390' wtr. 1050#

DST 4212-45 open 1 hr. Rec. 2200' wtr.

1050# DST 4796-4944 open 1 hr. Rec.

8' mud Cherokee 4560 Miss. 4971

TD 5180 5" @ 4835 DST 5055-5180

open 1 hr. Rec. 1144' wtr. CO to 2810

10/ 2800-05 500 A 10/2686-96 500 A

20/ 2686-96 500 A 16/ 2648-56

D & A

J. G. McGEHEE