

KANSAS

Kearney

FORM 51 5M 10-41 PETROL

Section 23 Township 22 Range 38-W

Well No. 2 Patterson


Company Stanolind

Patterson Pool

NORTH

WEST

EAST

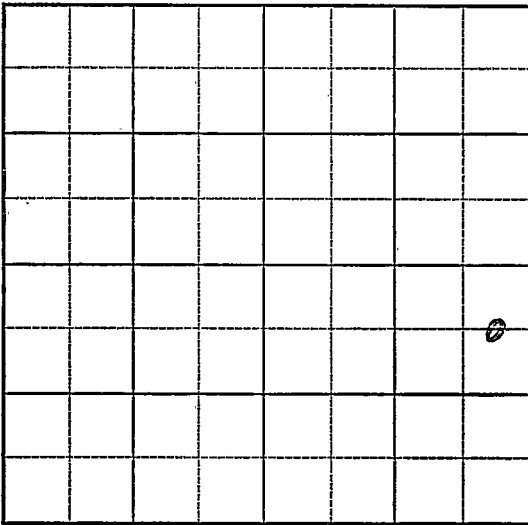

SOUTH

Kearny

KANSAS

Map No. MM Sec. 23 Twp. 22 R. 38WWell No. 2 PattersonStanolind Company**FIRST REPORT** Contractor

C E L N E S E

660 Ft. from N. Line

_____ Ft. from S. Line

330 Ft. from E. Line

_____ Ft. from W. Line

SECTION PLAT

			o

PATTERSON POOL

Location XXX

Rig up _____

Drilling and Remarks:

RECORD

Cased _____ in., _____ ft.

Sand _____

Gas _____

Oil _____

Total Depth _____

PRODUCTION

1st 24 hrs. Nat. _____

1st 24 hrs. after shot _____

Gas _____ Cu. Ft.

Dry Hole _____

Abandoned _____

Date

DEC 3 0 1941

19

S. J. LEWIS Scout

Map No. NM Sec. 23 Twp. 22 R. 38W

Well No. 2 Patterson

Stanolind Company

ABANDONED Contractor

C E L N E S E

SECTION PLAT

660 Ft. from N. Line

_____ Ft. from S. Line

330 Ft. from E. Line

_____ Ft. from W. Line

			o

PATTERSON POOL

Location _____

Rig up _____

Drilling and Remarks:

Miss 4895

No show

RECORD

Cased _____ in., _____ ft.

Sand _____

Gas _____

Oil _____

Total Depth 4954

PRODUCTION

1st 24 hrs. Nat. _____

1st 24 hrs. after shot. _____

Gas _____ Cu. Ft.

Dry Hole _____

Abandoned _____

Date

FEB 18 1942 19

S. J. LEWIS Scout