

Kearny


KANSAS

SECTION 23 TOWNSHIP 22 RANGE 38 W

WELL NO. #1 Patterson et al

COMPANY Huber Corp.

NORTH

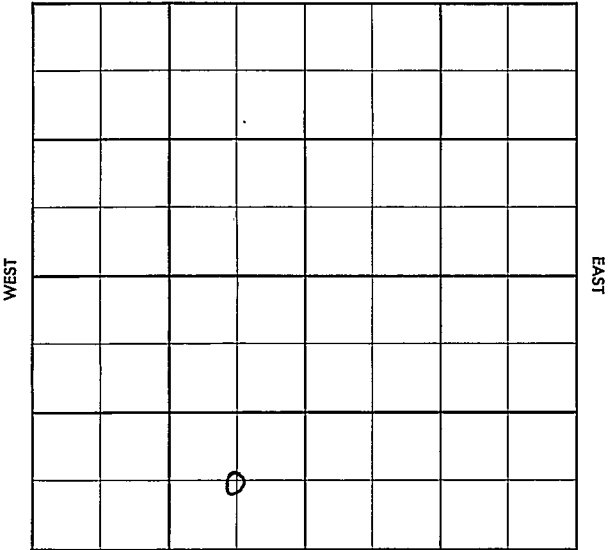

SOUTH

Kearny

KANSAS

SEC.

TWP.

R.

23

22

38W

WELL NO.

#1 Patterson etal

FARM

COMPANY

Huber Corp.

CONTRACTOR

Dutch George

Patterson


NORTH

_____ Ft. from N. Line

_____ Ft. from S. Line

_____ Ft. from E. Line

_____ Ft. from W. Line

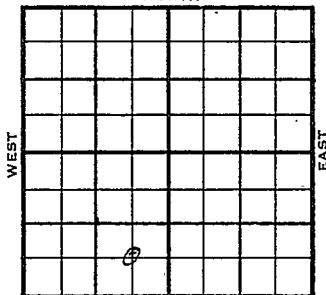

C SE SW

1956

ELEVATION

3347'

REPORT

##

1-18

~~WORT~~

Comm. 1-20-56

County Kearny Elev. 3347 (6)
 Sec. 23 Twp. 22 Rgs. 38W
 Company Huber Corp.
 Farm Name Patterson etal. No. 1

TOPS	DEPTH	LOG	DATUM
Anh.			
Tp.			
H.			
Tr.			
Dg.			
BL.			
L.			
K.C.			
B.K.C.			
Ce.			
C.			
M.			
M.			
K.			
Mz.			
Ma.			
V.			
S.			
S.			
A.			
R.			
PE.			
G.			
T.D.			

Loc. in Sec. C SE SW

Geol. _____

Contr. Dutch George

Pool Patterson

JAN 18 '56
 FIRST REPORT

Date Comm. WORT

[Handwritten signature]

Co.
 Sec.
 No.
 T.
 R.

CORRECTION

FORM 513 REV. SUNRAY

County Kearny Elev. 3347
 Sec. 23 Twp. 22 Rge. 38W
 Company Huber
 FarmName Patterson No. 1

TOPS	DEPTH	LOG	DATUM
Anh.			
TP.			
H.			
Tr.			
Dg.			
Bl.			
L.			
K.C.			
B.K.C.			
Ce.			
C.			
M.			
M.			
K.			
Mz.			
Me.			
V.			
S.			
S.			
A.			
R.			
PE.			
G.			
T.D.			

Loc. in Sec. C SE SW

Geol. _____

Contr. _____

Dutch George

Pool _____

Patterson

CORRECTION

MAR 7 58

0

Date Comm. 1-20-56

Elev. correction. Correct datums

~~34~~

Co.

Use

No.

Sec.

T.

R.