


KANSAS CORPORATION COMMISSION

WELL RECORD

6-22-24W

(Mail to Kansas Geological Survey, 4150 Monroe Street, Wichita, Kansas 67209)

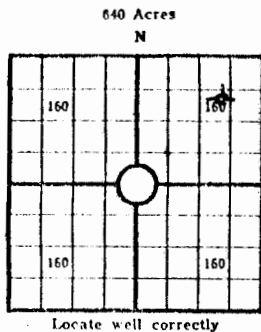

Lease Name: Schauvliege 'B' Well No. 4
 Well Located: App. C NE NE
SEC 6 TWP 22S RGE 24W
 Operator: Donald C. Slawson
 Address: Suite 408 One Twenty Building-Wichita, Kansas
 Elevation: Ground 2441 D.F. 2444 K.B. 2446
 Type Well: (Oil, gas, dry hole) Dry Hole

Drilling Commenced: December 30, 1971 Drilling Completed: January 7, 1972
 Well Completed: January 7, 1972 Total Depth 4575'
 Initial Production: D & A

Casing Record

Size: 8 5/8" Set at 594' Size: Set at
 Size: Set at Size: Set at

Liner Record

Size: Set from To

Cementing

Casing Size	Sacks	Type Cement and Additives
<u>8 5/8"</u>	<u>300</u>	<u>60-40 Poz with 3% HA-5</u>
<u> </u>	<u> </u>	<u> </u>
<u> </u>	<u> </u>	<u> </u>

Perforations

Formation	Perforated Interval and Number Shots
<u> </u>	<u> </u>
<u> </u>	<u> </u>
<u> </u>	<u> </u>

Electric Log Run (Show type log and depths covered)

NONE

Show Drill Stem Tests,
Well Stimulation and
Production Tests

6-22-24w

Formation Top Bottom

Surface Clay	0	165
Shale & Shells	165	1650
Anhydrite	1650	1685
Shale & Shells	1685	2433
Shale & Lime	2433	2649
Lime & Shale	2649	3318
Lime	3318	4575

DST #1 4507-75 Open 15", Shut in 30", Open
15", Shut in 30" Weak blow for 6" & died
Rec. 20' Mud w/no show BHP: 665#/575# FP:
68#-73#

SMP TOPS	DEPTH
ANHY	1650
HEEB	3880
LKC	3931
BKC	4311
CHER SH	4457
CHER LM	4465
MISS	4550
RTD	4575

