

KANSAS

Stafford

Section 24 Township 22 Range 14W

Well No. 1 Smith

Company A.B. & W.

Wildcat

NORTH

0							

WEST

EAST

SOUTH

Stafford
22

KANSAS
14W

Sec. 24 Twp. R.

Well No. #1 Smith Farm

A. B. & W

Company


Wildcat (A.B. & W, Cont.)

330' Ft. from N. Line

Ft. from S. Line

Ft. from E. Line

330' Ft. from W. Line

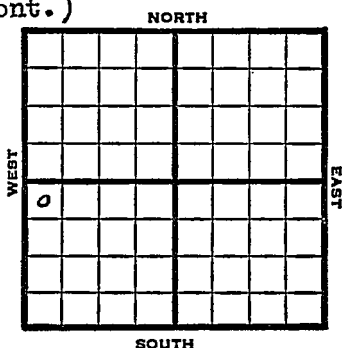

NW SW

1949 ^Llev 1927' REPORT

8/3 8" @ 319'
Drlg. 480'
8/10 Lansing 3447'
Drlg. 3476'
8/17 Viola 3711' Simpson 3740'
Arbuckle 3797'
5" @ 3798'
TD 3805'
500 acid swb 15 bbls oil PH
8/24 "
8/31 "
9/7 "
9/14 "
9/21 "
9/28 TD 3805'
Arb. 3797'
5" @ 3798'
500 acid
Pump 250 Oil / 4% W Pot
40° Gr.
Comp

COMPLETED

Kansas

Wildcat

Map No. _____ Sec. 24 Twp. 22 R. 14WWell No. 1 Smith

A. B. & W _____ Company

A. B. & W _____ Contractor

FIRST REPORT

NW SW

SECTION PLAT

330 Ft. from N. Line

_____ Ft. from S. Line

_____ Ft. from E. Line

330 Ft. from W. Line

o			

Stafford County

Location _____

Rig up _____

Drilling and Remarks:

8" @ 319

480

RECORD

Cased _____ in., _____ ft.

Sand _____

Gas _____

Oil _____

Total Depth _____

PRODUCTION

1st 24 hrs. Nat. _____

1st 24 hrs. after shot _____

Gas _____ Cu. Ft.

Dry Hole _____

Abandoned _____

Date

AUG 3 1949

19

S. J. LEWIS

Scout

Kansas

Wildcat

Map No. _____ Sec. 24 Twp. 22 R. 14WWell No. 1 Smith

A. B. & W. _____ Company

COMPLETE


Contractor

NW SW

E 1, 1927
SECTION PLAT330 Ft. from N. Line

_____ Ft. from S. Line

_____ Ft. from E. Line

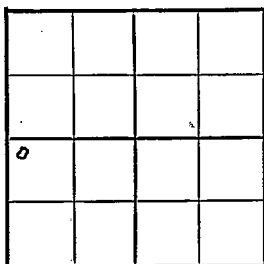330 Ft. from W. Line

Stafford County

RECORD

Location _____

Cased _____ in., _____ ft.

Rig up _____

Sand _____

Drilling and Remarks:

Gas _____

Oil _____

Total Depth 3825

PRODUCTION

1st 24 hrs. Nat. _____

1st 24 hrs. after shot _____

Gas _____ Cu. Ft.

Dry Hole _____

Abandoned _____

Date

SEP 28 1949

19

S. J. LEWIS Scout