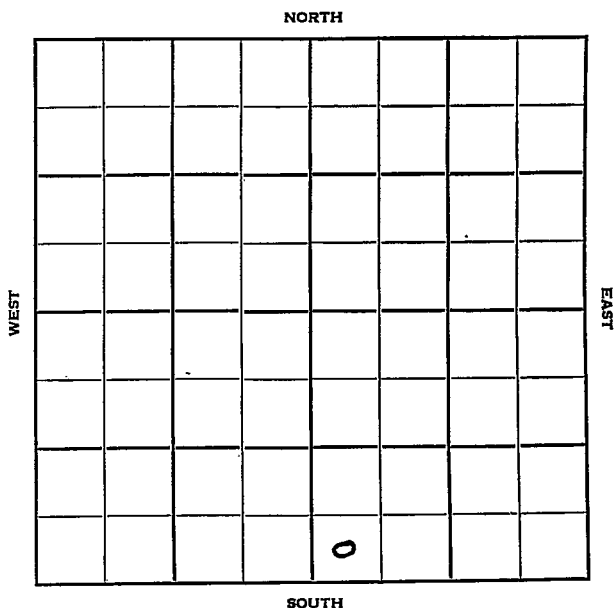


Section 24 Township 22 Range 9WWell No. #1 SchmuckerCompany Stagg Drlg.

Reno

KANSAS ✓

Sec. 24 Twp. 22 R. 9W

Well No. #1 Schmucker Farm

Stagg Drlg. Company

Stagg
Wildcat Contractor

 Ft. from N. Line

330


 Ft. from S. Line

 Ft. from E. Line

330

 Ft. from W. Line

SW SW SE

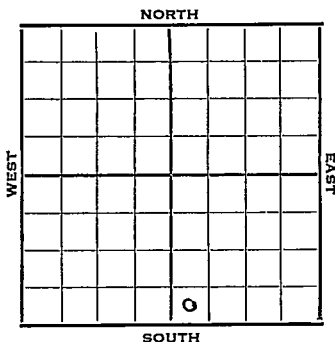

1952

Elev. 1707

R E P O R T

8/27

Spud 8-18-52

8" @ 301'

Drlg. 3132'

9/4

Spud 8-18-52

D&A TD 4000

8" @ 301

Lans. 3140 BKC 3480

Miss 3560

DST 3560-73 opn $\frac{1}{2}$ hr.

Rec. 15' mud Off

Kh 3608

Viola 3828

Simp 3871

Arb. 3945

TD 4000

D&A

ABANDONED

County	Reno		State		Kansas
Sec.	24 (Blk. Twp.)	22	(Sur. Rce.)	9W	Map No.

Operator Stage Drlg.

Well No. **1** Farm **Schmucker**

Elev.	Location	SW	SW	SE
-------	----------	----	----	----

FIRST REPORT

330 Ft. From S Line SE

350 Ft. From W Line Quarter

1st. Report AUG 27 1952

Completion

Remarks

Stage - Contr.

Spudding Date 8-18-52


Drlg. Data

Wildcat

8ⁿ @ 301 Drlg. 3132

J. G. McGEHEE

County Reno State Kansas
 Sec. 24 (Blk. Twp.) 22 (Sur. Rge.) 9W Map No. _____
 Operator Stagg Drlg.
 Well No. 1 Farm Schumacker
 Elev. 1707 Location SW SW SE

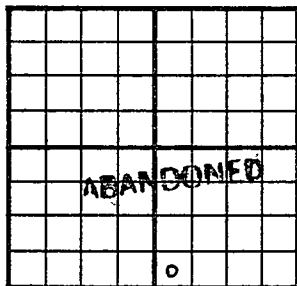

330 Ft. From S Line SE
330 Ft. From W Line Quarter

1st. Report

Completion SEP 4 1952

Remarks Wildcat

Stagg Drlg. - Contr.

Spudding Date 8-18-52

Drlg. Data D & A TD 4000

8" @ 301 Lans. 3140 B KC 3480

Miss. 3560 DST 3560-73 open $\frac{1}{2}$ hr.

Rec. 15' mud O# Kh. 3608 Viola 3828

Simp. 3871 Arb. 3945 TD 4000

D & A