



Sec. 24 Twp. 22 R. 5W

Well No. #1 Hartford Farm

Davis-Childs Company

Sterling Drlg. Contractor


\_\_\_\_\_ Ft. from N. Line

330 Ft. from S. Line

330 Ft. from E. Line

\_\_\_\_\_ Ft. from W. Line

SE SE SW  
Sinclair Farmout

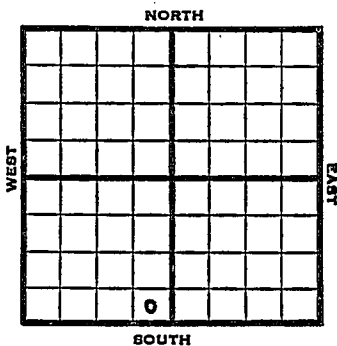

1953 Elev. 1505' REPORT

2/4 Spud 1-29-53  
8" @ 690  
Drlg. 1416'

2/12 Drlg. 3175'

2/19 Heeb 2459, Lans 2680', Miss  
3362, KH 3593, Miesner 3739  
Htn 3742 SO  
DST 3740-50, 30' M, 1325#  
V 3848, Simp 3865  
RTD 3867  
5" @ 3866

*Handwritten notes:*  
2680  
12 3/4  
75  
1  
3362  
12 3/4  
85  
1

2/26 DD 3870 TD  
S/5 BO 1/2 10 BWPB

3/4 Spud 1-29-53  
OilWell  
TD 3870  
8" @ 690  
Heeb 2459, Lans 2680, Miss  
3362, Kh. 3593, Misener 3739,  
Hunton 3742  
DST 3740-50, rec. 30' mud,  
1325#  
Viola 3848, Simp 3865  
TD 3867  
5" @ 3866  
DD 3870 S/5 bo 10 bwph S/5 bo  
12 bw 3 hrs.  
Comp. 50 bopd 120

**COMPLETED**

County Reno State Kansas

Sec. 24 (Blk. Twp.) 22 (Sur. Rge.) 5W Map No.

Operator Davis - Childs

Well No. 1 Farm Hartford

Elev. Location SE SE SW

<b>FIRST REPORT</b>									

350 Ft. From S Line SW

330 Ft. From E Line Quarter

1st. Report FEB 4 1953

Completion

Remarks Sinclair farmout

Sterling Drlg. - Contr.

Spudding Date 1-29-53

Drlg. Data

8" @ 690 drlg. 1416

