


Section 24 Township 22 Range 5W

Well No. #2 Robinson

Company Skelly

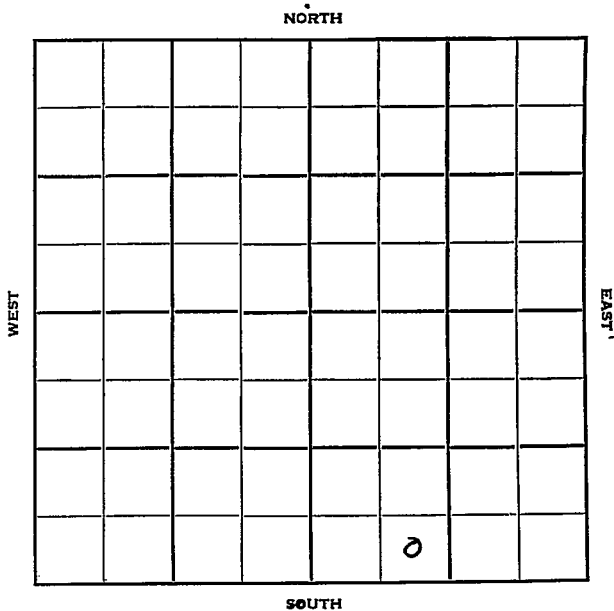

Reno

KANSAS

Sec. 24 Twp. 22 R. 5W

Well No. #2 Robinson Farm

Skelly Company

Contractor

Ft. from N. Line

330


Ft. from S. Line

Ft. from E. Line

990

Ft. from W. Line

SE SW SE

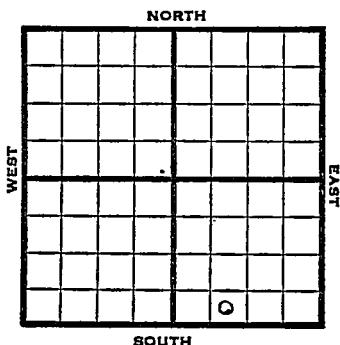

1952

Elev. 1499' REPORT

7/2

Spud 6-26-52
13" @ 120'
8" @ 670' WOC

7/9

Drlg. 2805'

7/17

Drlg. 3705'

7/23

Lans. 2676
KH 3601
Htn 3737
Simp. 3864

Miss 3367
Meisner 3736
V 3847

RTD 3865' 5" @ 3864'

7/30

CO 3865 B/1qt oph DD 3869 TD
S/18 Bo & 101 Bw 22 hrs. S/16
Bo & 93 BW 24 hrs.

8/6

NR

8/13

"

8/20

"

8/27

"

9/3

"

9/10

P/5 BO & 105 BWPD P/17 BO & 160 BWPD

OVER

1952

9/17

Spud 6-26-52

Oil well TD 3869' 13" @ 120-

8" @ 670 Lans. 2676' Miss 3367'

Kh. 3601' Misener 3736' Hunton 3737

Viola 3847' Simp 3864'

TD 3865' 5" @ 3864 DP 3865

B/1 qt PH DD 3869 S/18 BO 101 BW

22 hr.

S/16 BO 93 BW 24 hr.

3867

P/5 BO 105 BWPD

1499

Comp. 17 BOPD 60 BW

2365

COMPLETED

3367

1499

1868

County _____ State Kansas

Sec. 24 (Sik. Twp.) 22 (Sur. Rge.) 5W Map No.

Operator Skelly

Well No. 2 Farm Robinson

Elev. _____ Location SE SW SE

330 Ft. From S Line SE

990 Ft. From W Line Quarter

lst. Report JUL 2 1952

Completion _____

Remarks _____

Spudding Date 6-26-52

Drig. Data _____

13" @ 120 8" @ 670 WOC

J. G. McGEHEE

