

Reno

FORM 51

KANSAS

Section 24 Township 22 Range 5W

Well No. #3 Robinson

Company S kelly Oil

NORTH

WEST

EAST

SOUTH

0

Reno

KANSAS

SEC.	TWP.	R.
24	22	5W ✓

WELL NO.

3 Robinson

FARM

COMPANY

Skelly Oil

CONTRACTOR

Wentworth

Buehler Pool

Ft. from N. Line

660


Ft. from S. Line

Ft. from E. Line

330

Ft. from W. Line

C W L SW SE

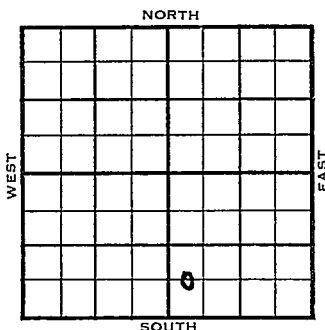

1954

ELEVATION

1502'

REPORT

4/21

Spud 4-17-54

8" @ 701', WOC

5/5

Lans 2685', Miss 3368', KH 3586',
 Meisner 3733', Htn 3737', Ma dol
 3746', Sylvan Sha 3781', V 3842',
 Simp. 3861'

RTD 3863'

5" @ 3862'

CO 3863'

5/12

5/19

DD 3879'

TD

3/10 BO 124 BW 11 hrs.

S/ 3 BO 35 BW 5 hrs. POP.

5/26

Spud 4-17-54 Oil well TD 3879

8" @ 701' Lans. 2685' Miss 3368'

Kh. 3586' Meisner 3733' Hunton 3737'

Maq. 3746' Sylvan sh. 3781'

Viola 3842' Simp. 3861' TD 3863'

5" @ 3862' CO to 3863' DD 3879'

S/10 BO 124 BW 11 hr.

S/3 BO 35 BW 5 hr.

Comp. 12 BOPD 156 BW

COMPLETED

County **Reno** State **Kansas**

Sec. **24** (Blk. **22** (Sur. **59** Map. No.)

Operator **Skelly Oil**

Well No. **3** Farm **Robinson**

Elev.	Location	C	WL	SW	SE
-------	----------	---	----	----	----

660 Ft. From S Line SE

330. Ft. From **W** Line Quarter

1st. Report APR 21 1954

Completion

Remarks


Wentworth - Contr.

Spudding Date **4-17-54**

Drlg. Data Buehler Pool

8th @ 701 WOC

J. G. McGEHEE

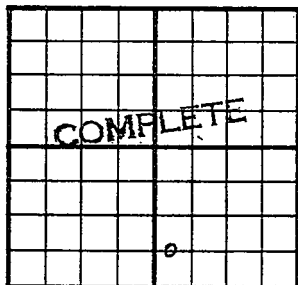County Reno State KansasSec. 24 (Blk. 22) (Sur. 5W) Map No.Operator Skelly OilWell No. 3 Farm RobinsonElev. 1502 Location C W L SW SE660 Ft. From S Line SE330 Ft. From W Line Quarter

1st. Report

Completion MAY 26 1954Remarks Buehler PoolWentworth - Contr.Spudding Date 4-17-54Drlg. Data Oil well TD 38798" @ 701 Lans. 2685 Miss. 3368Kh. 3586 Meisner 3733 Hunton 3737Maq. 3746 Sylvan sh. 3781 Viola 3842Simp. 3861 TD 3863 5" @ 3862 CO to3863 DD 3879 S/ 10 bo 124 bw 11 hr.S/ 3 bo 35 bw 5 hr. Comp. 12 bopd 156 b

J. G. McGEHEE