


Section 24 Township 22 Range 22WWell No. #1 RuffCompany G-M-R Drlg. Co.

NORTH

WEST

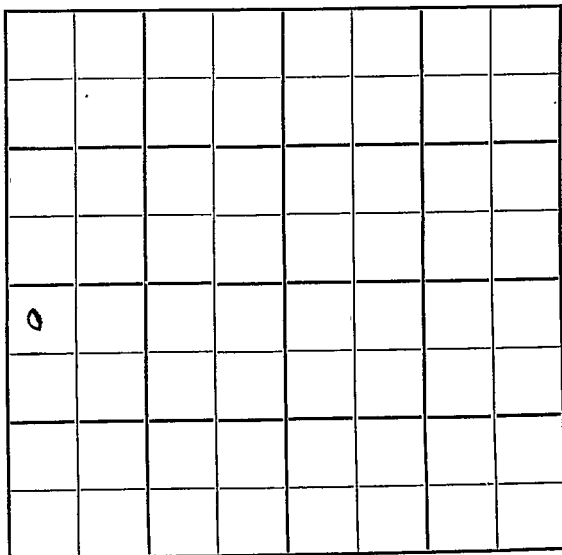

EAST

SOUTH

Hodgeman

KANSAS

Sec. 24 Twp. 22 R. 22W

Well No. #1 Ruff Farm

G-M-R Drlg. Co. Company

Contractor


330' Ft. from N. Line

\_\_\_\_\_ Ft. from S. Line

\_\_\_\_\_ Ft. from E. Line

330' Ft. from W. Line

NW NW SW

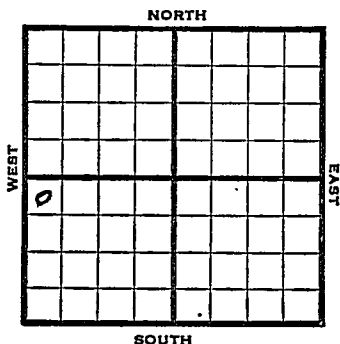

1952 Elev. 2157 REPORT

7/16 Spud 7-14-52  
10" @ 160

7/23 Drlg. 2745'

7/30 Anhy 1365 Heeb 3744  
Dodge 3760 Br. Li 3803  
KC 3819  
Drlg. 4181'

8/6 Spud 7-14-52  
D&A TD 4480  
10" @ 160  
Anhy 1365  
Heeb. 3744 Dodge 3760  
Br lime 3803 KC 3819  
Marm. 4186 Cong. 4378  
Weathered Miss. 4408  
Ch. Miss 4410 TD 4480  
D&A **ABANDONED**

**J. G. McGEHEE**

J. G. McGEHEE