

Company Shell

WEST

**EAST**

**SOUTH**

KANSAS

Hodgeman

Sec. 24 Twp. 22 R. 24-W

Well No. #2 Springer "A" Farm ✓

Shell Company

B & R Drlg. Contractor

Jetmore


         Ft. from N. Line

1012 Ft. from S. Line

990 Ft. from E. Line

         Ft. from W. Line

NW SE SW

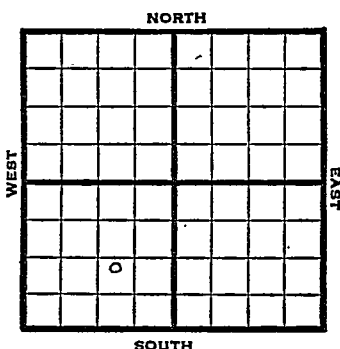

1950 Elev. 2406' REPORT

10/10 Drlg 100 Spud 10-10-50

12/6 Spud 10-10-50

Oil Well TD 4663

8" @ 821'

Cong. 4004 SO DST 4600-18

opn 2 hr Rec. 100' socm 120' hocm

Cong. 4602' Miss 4651

TD 4661' 4 1/2" @ 4600 24/4602-08

B/7 gw tr. oil 24/4608-14

B/4 gw tr. oil 8/4618-20

6 gal. sli salty wtr 1000 A S/49 bo

11 bs & w 10 hr S/21 bo 4 bw 4 hr

72/4602-20 S/32 bo 9 bw 6 hr

S/25 bo 3 bw 7 hr S/74 bo 12 bw 21 hr

DD 4663 S/23 bo 3 bs & w 28/4653-

4660 FU 1000' fluid B/4 bssw

S/17 bo 1/2 bw SP 4640 1000 A

S/47 bo 64 bw 15 hr. Comp. 86 bopd


29 bw

COMPLETED



J. E. TYRA

County Hodgeman State Kansas  
 Sec. 24 (Bk.) 22 (Sur.) 24W Map No.  
 Operator Shell  
 Well No. 2 Farm Springer "A"  
 Elev. 2406 Location NW SE SW

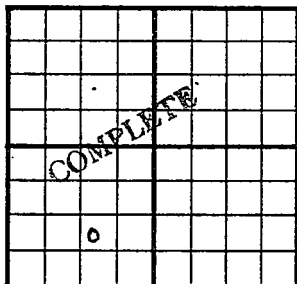

1012Ft. From S Line SW  
990Ft. From E Line Quarter  
 Ist. Report  
 Completion DEC 6 1950  
 Remarks Jetmore Pool  
B & R Drlg. - Contr.  
 Spudding Date 10-10-50

Drlg. Data Oil well TD 4663  
8" C 821 Cong. 4004 SO DST 4600-18  
open 2 hr. Rec. 100' socm 120' hocm  
Cong. 4602 Miss. 4651 TD 4661  
4 $\frac{1}{2}$ " @ 4660 24/ 4602-08 B/ 7 gw tr. oil  
24/ 4608-14 B/ 4 gw tr. oil 8/ 4618-20  
6 gal. sli salty water 1000 A S/ 49 bo  
11 bs & w 10 hr. S/ 21 bo 4 bw 4 hr.  
72/ 4602-20 S/ 32 bo 9 bw 6 hr.  
S/ 25 bo 3 bw 7 hr. S/ 74 bo 12 bw 21 hr.  
DD 4663 S/ 23 bo 3 bs & w 28/ 4653-4660  
FU 1000' fluid B/ 4 bssw S/ 17 bo  $\frac{1}{2}$  bw  
SP 4640 1000 A S/ 47 bo 64 bw 15 hr.  
Comp. 86 bopd 29 bw

J. E. TYRA