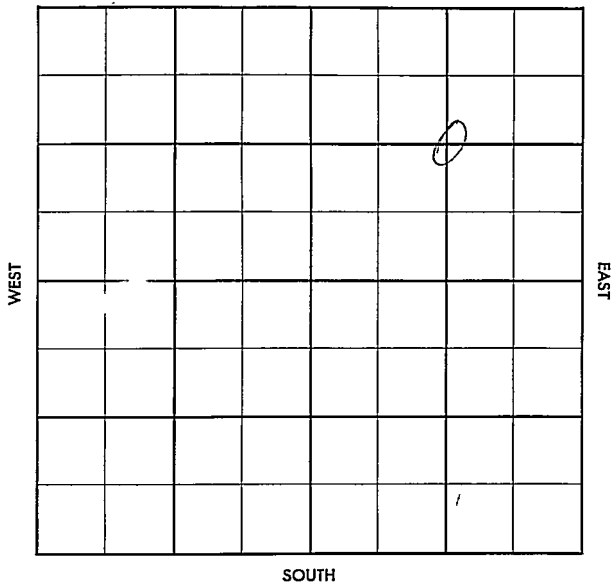


Finney

KANSAS

SECTION 24 TOWNSHIP 22 RANGE 33WWELL NO. #1 J.W. BebermeyerCOMPANY The Texas Co., etal

NORTH

C NE $\frac{1}{4}$ 

County Finney Elev. 2871 DF
 Sec. 24 Twp. 22 Rge. 33W
 Company The Texas Co. et al
 Farm Name J. W. Bebermeyer No. 1

TOPS#	DEPTH	LOG	DATUM	Loc. in Sec.
Anh.				C NE/4
Tr.				
H. <u>HOLL</u>		<u>2550</u>		
Tr.				
Dg. <u>Herr</u>		<u>2570</u>		
BL.				
L. <u>Kri</u>		<u>2578</u>		Geol.
K.C.				Contr.
B.K. <u>Winf</u>		<u>2637</u>		Noble Drlg.
Ce.				Pool
C.				Hugoton
M.				
M.				
K.				
Mz.				
Ma.				
V.				
S.				
S.				
A.				
R.				
PE.				
G.				
T.D.	<u>2645</u>	<u>2643</u>		

FIRST REPORT	

Date Comm. 3-12-57

11" @ 528/350, 5" @ 2640/800 WOC

~~35~~

County Finney Elev. 2871 DF
 Sec. 24 Twp. 22 Rge. 33W
 Company The Texas Co. et al
 Farm Name J. W. Bebermeyer No. 1

TOPS	DEPTH	LOG	DATUM	Loc. in Sec.
Anb.				C NE/4
TP.				
H. <u>Holl</u>		<u>2550</u>		
Tr.				
Dg. <u>Herr</u>		<u>2570</u>		
Bl.				
L. <u>Kri</u>		<u>2578</u>		
K.C.				Geol. _____
BKC. <u>Winf</u>		<u>2637</u>		Contr. _____
Ce.				Noble Drlg.
C.				
M.				
M.				Pool
K.				Hugoton
Mz.				
Mo.				
V.				
S.				
S.				
A.				
R.				
Pe.				
G.				
T.D.	<u>2645</u>	<u>2643</u>		

MAY 8 '57

ABANDONED

Date Comm. 3-12-57

1" @ 528/350, 5" @ 2640/800 WOC MAR 27 '57

WOC T PH 17 '57 APR 17 '57 CG

CO 2645 N.S. DD 2650 TD 1st
 dry PB 2630 128/2580-2612
 USSG 11 tstd S.G. FRAC 12 1/2
 1st 638 MCFG + 40 GWPH 9a
 1.185 MCFG pd + 144 GWPH 18g
 w/PRK to 2572 50d. PF's WOC
 APR 24 '57 CO 2630 64/2580-96

Frac tst 327 MCF + 300

Gwph 54d CO 2622 40/

2580-90 SC PB 2592 MAY 1 '57

Frac tst 84 MCF + 60 Gwph

CO 2615 32/2604-12 NO

INC Frac 90 520 MCF +

+150 G Acid wph MAY 8 '57

54d 2580-90 G 2604-12 IF

24/2551-57 Frac \$ 50

G. Acid wth no sk. gas

DEN