

Finney

KANSAS


SECTION 24 TOWNSHIP 22 RANGE 33WWELL NO. #1 Finnup "C"COMPANY W.L. Hartman

NORTH

~~SW~~ SW SW SW

WEST

EAST

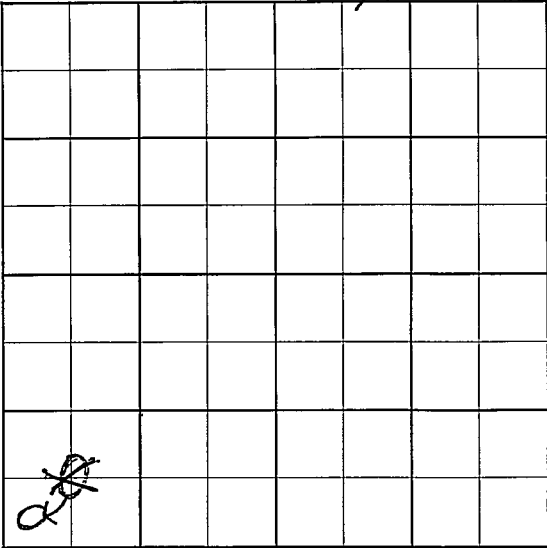

SOUTH

WILDCAT

FORM 513 SUNRAY

County Finney Elev.
 Sec. 24 Twp. 22 Rge. 33W
 Company W. L. Hartman
 Farm Name Finnup "C" No. 1

TOPS	DEPTH	LOG	DATUM
Anh.			
Tr.			
H.			
Tr.			
Dg.			
Bl.			
L.			
K.C.			
B.K.C.			
Ce.			
C.			
M.			
M.			
K.			
Mz.			
Ma.			
V.			
S.			
S.			
A.			
R.			
Pe.			
G.			
T.D.			

Loc. in Sec. C SW SW

Miss Test

Geol.

Contr.

Co. Tools

Pool

Wildcat

JUL 3 '57

FIRST REPORT

Date Comm. 6-27-57
10" @ 286/200, Drlg. 2600

[Handwritten signature]

4738
2871
1867

CORRECTION

FORM 513 SUNRAY

Co.

Lse.

No.

Sec.

T.

R.

County Finney Elev. 2871 DE
Sec. 24 Twp. 22 Rge. 33W
Company W. L. Hartman
Farm Name Finnup "C" No. 1

TOPS	DEPTH	LOG	DATUM
Anh. <u>Holl</u>	<u>2530</u>		
TP. <u>Herr</u>	<u>2559</u>		
H. <u>KFI</u>	<u>2583</u>		
Tr. <u>Odell</u>	<u>2602</u>		
Dg. <u>WEd</u>	<u>2620</u>		
Bl. <u>9870</u>	<u>2648</u>		
L. <u>J F R 14</u>	<u>2677</u>		
K.C. <u>L F R 14</u>	<u>2741</u>		
B.K.C. <u>TP</u>	<u>3548</u>		
Ce. <u>H6</u>	<u>3845</u>		
C. <u>TR</u>	<u>3862</u>		
M. <u>LS9</u>	<u>3891</u>		
M. <u>DKC</u>	<u>4374</u>		
K. <u>Malm</u>	<u>4399</u>		
Mz. <u>CC</u>	<u>4519</u>		
Mo. <u>Miss</u>	<u>4738</u>		
V.			
S.			
S.			
A.			
R.			
Pe.			
G.			
TD.	<u>4838</u>		

Loc. in Sec. SW SW SW
Miss Test

Geol. X
Contr. X
Co. Tools X

Pool X
Wildcat X

COMPLETE	
OCT 9 57	

Date Comm. 6-27-57

10" @ 286/200, Drlg. 2600 JUL 13 57 Tite
ID 4047 ID 4726
Tite ID in tite
(need 1st 2 cores) 7" 2702 Tite
AUG 1 57 AUG 28 57 SEP 4 57 SEP 11 57 SEP 18 57
ID. m.c.F Rock P 380
SEP 25 57 OCT 2 57
Hughesoton pay zone