

Finney


KANSAS,

SECTION 24 TOWNSHIP 22 RANGE 34W

WELL NO. #1 Garden City Co.

COMPANY Hartman

NORTH C SE/4

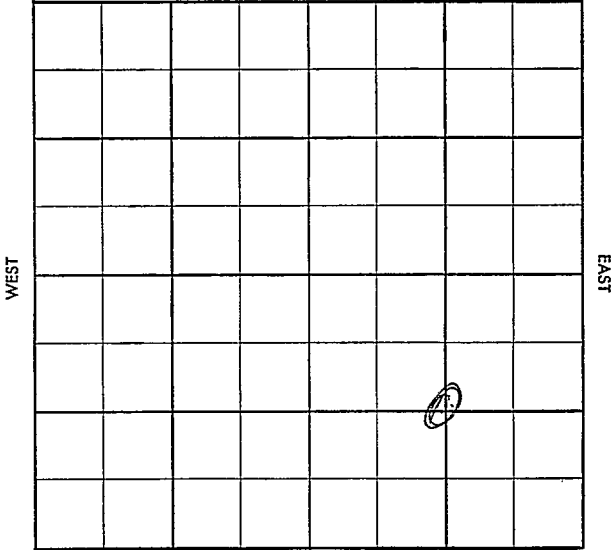

SOUTH
/

35

County Finnear Elev. _____
 Sec. 24 Twp. 22 Rge. 34W
 Company Hartman
 Farm Name Garden City Co. No. 1

TOPS	DEPTH	LOG	DATUM
Anh.			
Tp.			
H.			
Tr.			
Dg.			
B.L.			
L.			
K.C.			
B.K.C.			
Ce.			
C.			
M.			
M.			
K.			
Mz.			
Mq.			
V.			
S.			
S.			
A.			
R.			
Pf.			
G.			
T.D.			

Loc. in Sec. _____

C SE/4

Geol. _____

Contr. _____

Co. Tools _____

Pool _____

Hugoton**FIRST REPORT****JAN 22 '58**

Date Comm. _____

Location

Co.

Lse.

No.

Sec.

T.

R.

Twp. 1 Pool X

Co. X Facet

5-513-B

County Finney Elev. 2924 KB
 Sec. 24 Twp. 22 Rge. 34W 2921DF
 Company Hartman
 Farm Name Garden City Co. No. 1

TOPS	DEPTH	LOG	DATUM
Anh.			
Tp.			
H. <u>H61</u>		<u>2531</u>	
Tr. <u>H61</u>		<u>2531</u>	<u>2561</u>
Dg. <u>KH1</u>		<u>2583</u>	
B.L.			
Lr. <u>W1H</u>		<u>2614</u>	
K.C. <u>B W1H</u>		<u>2636</u>	
B.K.C. <u>V Foz</u>		<u>2672</u>	
Ce.			
C.			
M.			
M.			
K.			
Mz.			
Mq.			
V.			
S.			
S.			
A.			
R.			
Pf.			
G.			
T.D.	<u>2750</u>		

Loc. in Sec. C SE/4

Geol.

Cntr. Co. Tools

Pool

Hugoton

COMPLETE

MAY 28 58

Date Comm.

Location 1129 58 Spud 1-23-58

7" 2750 woc

FEB 12 58 FEB 19 58 FEB 26 58 MAR 5 58 MAR 12 58

MIC 7 MAR 19 58 MAR 26 58 APR 2 58 APR 9 58

APR 16 58 APR 23 58 APR 30 58 CO 2636 57/2620

-30 300A (A) frac ga 10 muf

+Ld. Sp 50/2586-91 130/2565-79

(A) frac ga 1.300 muf. w o t s t s MAY 7 58

MAY 14 58 MAY 21 58 MAY 28 58 72-20 ga 1.970 muf

RP 375 PB 2600