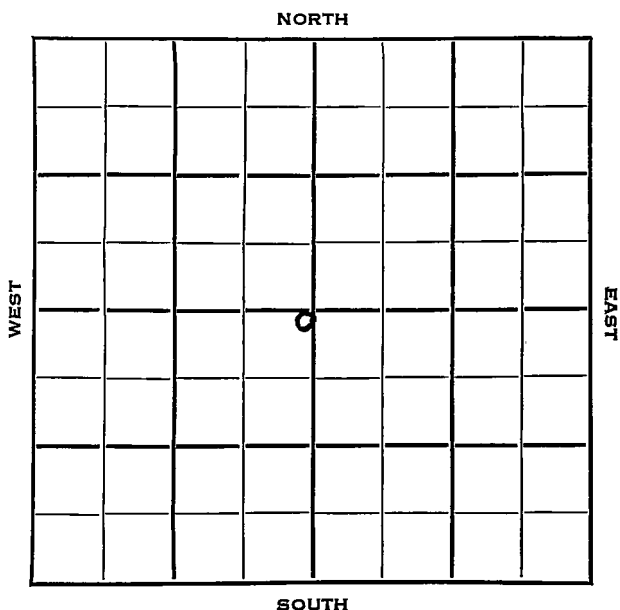


Section 24 Township 22 Range 34WWell No. 1 ^{MILLER}
~~Garden City Gas Unit~~Company Texas Company

Finney KANSAS

SEC.	TWP.	R.
24	22	3 4W ✓
WELL NO.		
1 Garden City Gas Unit ^{MILLER}		
COMPANY		FARM
Texas Company		
CONTRACTOR		


Hugton Pool

Ft. from N. Line

2590 Ft. from S. Line

Ft. from E. Line

2590 Ft. from W. Line

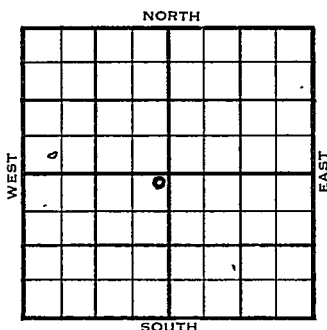

NE NE SW

	ELEVATION	REPORT
1954	2922'	

1/27	Location
2/10	10" @ 50' w/375 sks TD 2655' 7" @ 2654' Her. 2541', Win 2601'
3/10	Spud 2-2-54 10" @ 501' Her. 2541', Kri 2566', Win 2601' TD 2655' 7" @ 2654' CO to 2631' 36/2602-14 A-frac 27 gswph CO to 2586 75/2573-78, 5000A A-frac, CO to 2587' 66/2556-78, 3000A Comp. 223,000 gas, 75 gwph

COMPLETED

County Finney State Kansas

Sec. **24** (Blk. **22** (Sur. **34W** Map No.

Operator Texas Company

Well No. 1 Farm Garden City Gas Unit

Elev.		Location	NW NE SW
-------	--	----------	-----------------

[illegible]

2590 Ft. From S Line SW

2590 Ft. From W Line Quarter

1st. Report JAN 27 1954

Completion _____


Remarks

Spudding Date

Drlg. Data Eugeon Pool

~~Location~~

County Finney State Kansas
 Sec. 24 (Blk. 22) (Sur. 34W) (Rge. Map No.)
 Operator Texas Company
 Well No. 1 Farm Miller
 Elev. 2922 Location NE NE SW

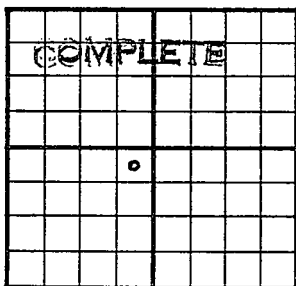

2590 Ft. From S Line SW

2590 Ft. From W Line Quarter

Ist. Report

Completion MAR 10 1954

Remarks Hugoton Pool

Spudding Date 2-2-54

Drlg. Data Gas well TD 2655

10" @ 501 Her. 2541 Kri. 2566

Win. 2601 TD 2655 7" @ 2654

CO to 2631 36/ 2602-14 A-frac

27 gswph CO to 2586 75/ 2573-78

5000 A A-frac CO to 2587 66/ 2556-78

3000 A Corp. 223,000 gas 75 gwph

*Correct name
 from Jones
 6/24
 J. G. McGehee*

J. G. McGEHEE