


Kearny

KANSAS

Section 24 Township 22 Range 35W

Well No. #1 Esklund

Company Warren Petroleum

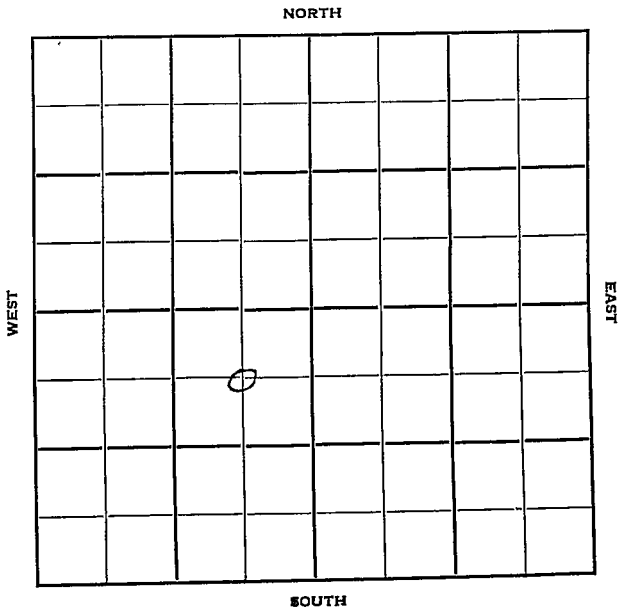

Sec. 24 Twp. 22 R. 35W ✓

Well No. #1 Esklund Farm

Warren Petroleum Company

Contractor

Hugoton Pool


660' Ft. from N. Line

 Ft. from S. Line

660' Ft. from E. Line

 Ft. from W. Line

C NE SW

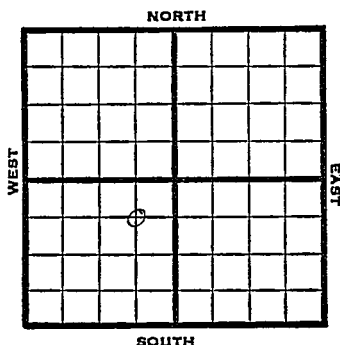

1950

Elev. 3007' REPORT

4/26

Location

6/21

10" @ 217'

7" @ 2513'

TD 2616'

120 qt/25,0-80

64 qt/2600-16

Acid 17,000

90 qt. 2600-16

Acid 14,000

127' of 5" Miner

Comp. 27,000,000 gas 410#

Her. 2550-80

Win. 2600-16

TD 2616'


COMPLETED

15355

Map No. _____ Sec. 24 Twp. 22 R. 35WWell No. 1 Esklund_____
Warren Petroleum Company_____
Contractor

C NE SW

SECTION PLAT

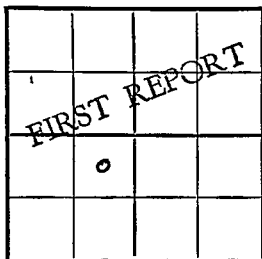660 Ft. from N. Line_____
Ft. from S. Line660 Ft. from E. Line_____
Ft. from W. Line

Kearny County

Location X

Rig up _____

Drilling and Remarks:

RECORD

Cased _____ in., _____ ft.

Sand _____

Gas _____

Oil _____

Total Depth _____

PRODUCTION

1st 24 hrs. Nat. _____

1st 24 hrs. after shot _____

Gas _____ Cu. Ft.

Dry Hole _____

Abandoned _____

Date

APR 26 1950 19 J. E. TYRA Scout

Map No. _____ Sec. 24 Twp. 22 R. 35WWell No. 1 Esklund

Warren Pet.

Company _____

Contractor _____


C NE SW

E1. 3007
SECTION PLAT660 Ft. from N. Line

_____ Ft. from S. Line

660 Ft. from E. Line

_____ Ft. from W. Line

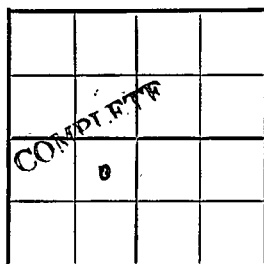

Kearny County

Location _____

Rig up _____

Drilling and Remarks:

10" @ 217

7" @ 2513

TD 2616

120 qt/ 2550-80

64 qt/ 2600-16

17000 acid

90 qt. 2600-16

14000 acid

Date _____

RECORD

Cased _____ in., _____ ft.

Sand _____

Gas _____

Oil _____

Total Depth 2616

PRODUCTION

1st 24 hrs. Nat. _____

1st 24 hrs. after shot _____

Gas _____ Cu. Ft.

Dry Hole _____

Abandoned _____

JUN 21 1950

19

J. E. TYRA Scout

127' of 5" liner

Comp. 27,000,000 gas 410#


Her. 2550-80

Win. 2600-16

Misc.
Pierce Map
France Map
Traces
Land Wall Map
Land Small Map
Scout Cards

REC'D JUN 20 1950

RECORD

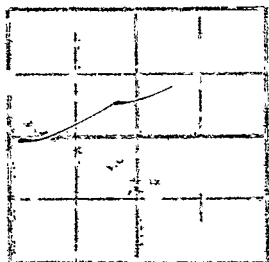

SECTION 1741

CONTRACT

MADE BY

DATE

NOTE TO THE USER