

24


22

36W

Section _____ Township _____ Range _____

1 Van Doren

Well No. _____

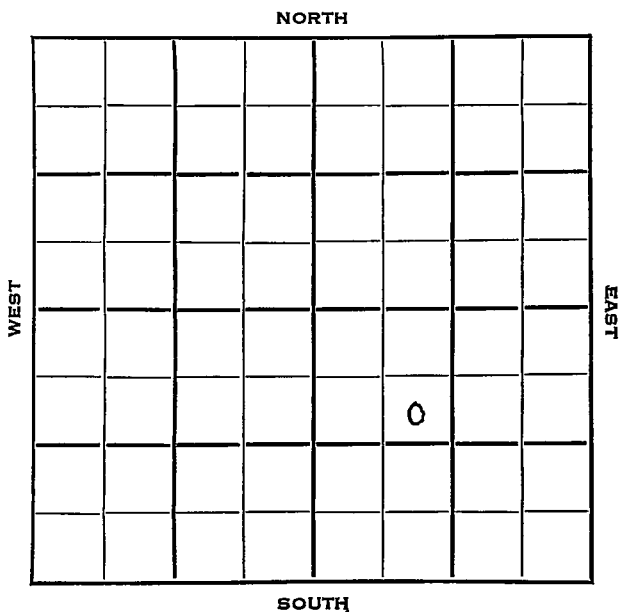Company E. W. Campbell

Kearny


KANSAS ✓

Sec. 24 Twp. 22 R. 36WWell No. #1 VanDoren FarmE. W. Campbell Company

Contractor

990 Ft. from N. Line Ft. from S. Line Ft. from E. Line990 Ft. from W. Line

SE NW SE

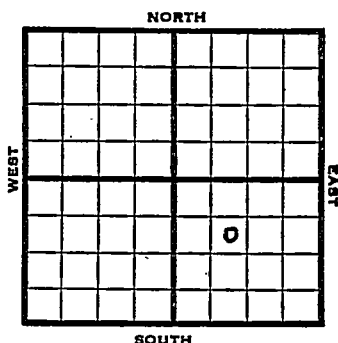

1953 Elev. 3112' REPORT

1/14 Spud 12-12-52
 10" @ 218
 T_d 2550
 7" @ 2548

1/22 NR

1/29 NR

2/5 DD 2600'

2/12 NR

2/19 "

2/25 Spud 12-12-52

Gas Well

TD 2600

10" @ 218

TD 2550

7" @ 2548

DD 2587

3000A DD 2600

10000A

Comp. 8 mcf/gpd 410#

COMPLETED


Sec. 24 (Blk. Twp.) 22 (Sur. Rge.) 36W Map No.

Operator E. W. Campbell

Well No. 1 Farm Van Doren

Elev. 3172 Location SE NW SE

FIRST REPORT

0

990 Ft. From N Line SE

990 Ft. From W Line Quarter

1st. Report JAN 14 1953

Completion


Remarks

Spudding Date 12-12-52

Prila. Data

10th @ 218 FD 2550 7th @ 2548

County Kearny State Kansas
 Sec. 24 (^{Blk.}Twp.) 22 (^{Sur.}Rge.) 36W Map No. _____
 Operator E. W. Campbell
 Well No. 1 Farm Van Doren
 Elev. 3112 Location SE NW SE

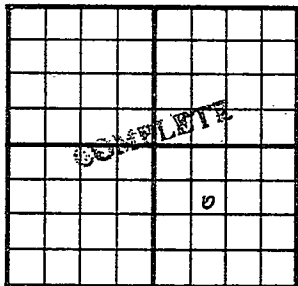

990 Ft. From N Line SE
990 Ft. From W Line Quarter
 1st. Report _____
 Completion FEB 25 1953
 Remarks _____

Spudding Date 12-12-52

Drilg. Data Gas well TD 2600
10" @ 218 TD 2550 7" @ 2548 DD 2587
3000 A DD 2600 10000 A
Comp. 8 mcf/gpd 410#

J. G. McGEHEE