

STATE CORPORATION COMMISSION OF KANSAS
OIL & GAS CONSERVATION DIVISION

L COMPLETION OR RECOMPLETION FORM
ACO-1 WELL HISTORY

DESCRIPTION OF WELL AND LEASE

Operator: license # 5161
name Palomino Petroleum
address
Route 5 Box 51-C
City/State/Zip Newton, Kansas 67114

Operator Contact Person Bob Watchous
Phone (316) 283-0232

Contractor: license # 5476
name DNB Drilling Co., Inc.

Wellsite Geologist Larry Friend
Phone (316) 265-2228

PURCHASER D & A

Designate Type of Completion

☒ New Well ☐ Re-Entry ☐ Workover

☐ Oil ☐ SWD ☐ Temp Abd
☐ Gas ☐ Inj ☐ Delayed Comp.
☒ Dr ☐ Other (Core, Water Supply etc.)

If OWWO: old well info as follows:

Operator
Well Name
Comp. Date Old Total Depth

WELL HISTORY

Drilling Method: ☒ Mud Rotary ☐ Air Rotary ☐ Cable
12-12-85 12-18-85 12-18-85
Spud Date Date Reached TD Completion Date

4724
Total Depth PBTD

Amount of Surface Pipe Set and Cemented at 250 feet

Multiple Stage Cementing Collar Used? ☐ Yes ☐ No

If Yes, Show Depth Set feet

If alternate 2 completion, cement circulated
from feet depth to w/ SX cmt

API NO. 15 - 083-21,231

County Hodgeman

NW NE SW Sec 21 Twp 22 Rge 25
(location)

2310 Ft North from Southeast Corner of Section

3630 Ft West from Southeast Corner of Section

(Note: locate well in section plat below)


Lease Name Potter Trust Well# 1

Field Name Wildcat

Producing Formation D & A

Elevation: Ground 2534 KB 2539

Section Plat

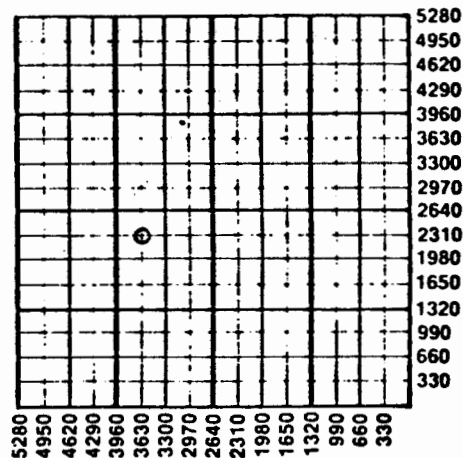

WATER SUPPLY INFORMATION

Source of Water:

Division of Water Resources Permit #

☐ Groundwater Ft North From Southeast Corner and
(Well) Ft West From Southeast Corner of

Sec Twp Rge ☐ East ☐ West

☐ Surface Water Ft North From Southeast Corner and
(Stream, Pond etc.) Ft West From Southeast Corner

Sec Twp Rge ☐ East ☐ West

☐ Other (explain)
(purchased from city, R.W.D.#)

Disposition of Produced Water: ☐ Disposal
☐ Repressuring

Docket #

INSTRUCTIONS: This form shall be completed in duplicate and filed with the Kansas Corporation Commission, 200 Colorado Derby Building, Wichita, Kansas 67202, within 90 days after completion or recompletion of any well. Rules 82-3-130 and 82-3-107 apply.

Information on side two of this form will be held confidential for a period of 12 months if requested in writing and submitted with the form. See rule 82-3-107 for confidentiality in excess of 12 months.

One copy of all wireline logs and drillers time log shall be attached with this form. Submit CP-4 form with all plugged wells. Submit CP-111 form with all temporarily abandoned wells.

Operator Name Palomino Petroleum Lease Name Potter Trust Well# 1 SEC 21 TWP. 22 RGE. 25 ☐ East ☒ West

WELL LOG

INSTRUCTIONS: Show important tops and base of formations penetrated. Detail all cores. Report all drill stem tests giving interval tested, time tool open and closed, flowing and shut-in pressures, whether shut-in pressure reached static level, hydrostatic pressures, bottom hole temperature, fluid recovery, and flow rates if gas to surface during test. Attach extra sheet if more space is needed. Attach copy of log.

Drill Stem Tests Taken ☒ Yes ☐ No
 Samples Sent to Geological Survey ☐ Yes ☐ No
 Cores Taken ☐ Yes ☒ No

Formation Description
☐ Log ☐ Sample

Name

Top


Bottom

PALOMINO PETROLEUM

#1 POTTER TRUST

21-22-25W
NW NE SWCONTR DNB DRILLINGCTY HODGEMANGEOL LARRY FRIENDFIELD WC(5/8 SW OF HALLET)

ELV 2539 KB SPD 12/12/85 CARD ISSUED 1/16/86 IP D&A/MISS
12/18/85

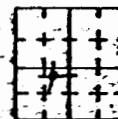

SMP	Tops	Depth/Datum
ANH		1697+ 842
HEEB		3939-1400
LANS		3991-1452
STARK		4294-1755
FT SC		4543-2004
MISS LM		4649-2110
RTD		4724-2185
NO LOG		

API 15-083-21,231

8 5/8 " 250 / 200SX

DST (1) 4538-4694 (MARM, MISS) / 20-15-0-0, REC 30' M, ISIP
125#, IFP 113-113#

COPYRIGHT 1985
 INDEPENDENT OIL & GAS SERVICE, INC.
 WICHITA, KANSAS

No Elog
D&A

CASING RECORD

☒ new☐ used

Report all strings set - conductor, surface, intermediate, production, etc.

Purpose of string	size hole drilled	size casing set (in O.D.)	weight lbs/ft.	setting depth	type of cement	# sacks used	type and percent additives
Surface.....	12 1/4	8 5/8	20	250	60-40 Pozmix	200	2%gel, 3%cc
.....							
.....							
.....							

PERFORATION RECORD

Acid, Fracture, Shot, Cement Squeeze Record

shots per foot	specify footage of each interval perforated	(amount and kind of material used)	Depth
.....			
.....			
.....			
.....			
.....			

21- 22- 2500



DNB Drilling, Inc.

ROTARY CONTRACTOR DRILLING DEALS

J. L. DONELSON, PRES.
(316) 687-5471

535 NORTH OLIVER

WICHITA, KANSAS 67208

DRILLERS' LOG

Palomino Petroleum
P.O. Box 18610
Wichita, KS 67218

#1 Potter Trust
NW NE SW Sec. 21-22-25
Hodgeman County, Kansas

Commenced: 12-12-85
Completed: 12-18-85

Surface casing: Ran 6 jts. 8 5/8", 20# new casing. Tallied 241.98',
set @ 250'. Cemented with 200 sx 60/40 poxmix, 2%
gel, 3% cc. Cement did circulate.

FORMATION


Sand & Shale
Anhydrite
Shale
Shale & Lime
Lime

DEPTH

0-1707
1707-1730
1730-3330
3330-4190
4190-4724 RTD

I do hereby certify that the foregoing statements are true and
correct to the best of my knowledge and belief.

DNB Drilling, Inc.

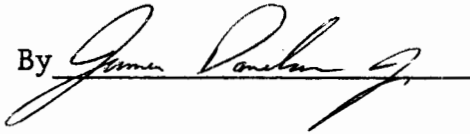By 

STATE OF KANSAS: ss:

Subscribed and sworn to before me this 24th day of December, 1985.

Vicky L. Coppage, Notary Public

My appointment expires:
May 28, 1989

