

IMPORTANT
Kans. Geo. Survey request
samples on this well.

S. 35 T. 22 R. 25 E W

API No. 15 — 083 — 20,361
County Number

Loc. NE NW

County Hodgeman

Operator
O. A. Sutton

Address 800 Sutton Place Wichita, Kansas 67202


Well No. #1 Lease Name Walter

Footage Location
660 feet from (N) (S) line 660 feet from (E) (W) line

Principal Contractor Geologist
Gabbert-Jones, Inc. Charles I. Slagle

Spud Date Total Depth P.B.T.D.
May 20, 1974 4745'

Date Completed Oil Purchaser
May 31, 1974

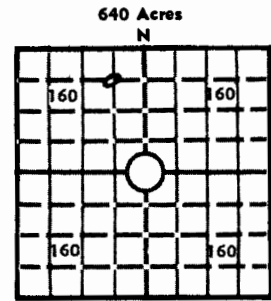

Locate well correctly
Elev.: Gr. 2529'

DF 2531' KB 2534'

CASING RECORD

Report of all strings set— surface, intermediate, production, etc.

Purpose of string	Size hole drilled	Size casing set (in O.D.)	Weight lbs/ft.	Setting depth	Type cement	Sacks	Type and percent additives
Surface		8-5/8"	28#	571'	common	275	2% gel, 3% cc

LINER RECORD

PERFORATION RECORD

Top, ft.	Bottom, ft.	Sacks cement	Shots per ft.	Size & type	Depth interval

TUBING RECORD

Size	Setting depth	Packer set at

ACID, FRACTURE, SHOT, CEMENT SQUEEZE RECORD

Amount and kind of material used	Depth interval treated

INITIAL PRODUCTION

Date of first production		Producing method (flowing, pumping, gas lift, etc.)			
RATE OF PRODUCTION PER 24 HOURS		Oil bbls.	Gas MCF	Water bbls.	Gas-oil ratio CFPB
Disposition of gas (vented, used on lease or sold)				Producing interval (s)	

INSTRUCTIONS: As provided in KCC Rule 82-2-125, within 90 days after completion of a well, one completed copy of this Drillers Log shall be transmitted to the State Geological Survey of Kansas, 4150 Monroe Street, Wichita, Kansas 67209. Copies of this form are available from the Conservation Division, State Corporation Commission, 3830 So. Meridian (P.O. Box 17027), Wichita, Kansas 66217. Phone AC 316-522-2206. If confidential custody is desired, please note Rule 82-2-125. Drillers Logs will be on open file in the Oil and Gas Division, State Geological Survey of Kansas, Lawrence, Kansas 66044.

Operator

O. A. Sutton

DESIGNATE TYPE OF COMP.: OIL, GAS,
DRY HOLE, SWDW, ETC.:
Dry Hole

Well No. 1	Lease Name Walter
---------------	----------------------

S 35 T 22S R 25 ^{EX} W


WELL LOG

Show all important zones of porosity and contents thereof; cored intervals, and all drill-stem tests, including depth interval tested, cushion used, time tool open, flowing and shut-in pressures, and recoveries.

SHOW GEOLOGICAL MARKERS, LOGS RUN, OR OTHER DESCRIPTIVE INFORMATION.

FORMATION DESCRIPTION, CONTENTS, ETC.	TOP	BOTTOM	NAME	DEPTH
DST #1, 4695-4710', open 1 hour, rec. 30' mud; IBHP 1380# 45 min., FBHP 1377# 45 min.; FP 26-35#; temp 120.			Log tops:	
			Anhydrite	1720 (plus 814)
			Heebner	3970 (-1436)
			Lansing	4030 (-1496)
			Stark	4337 (-1803)
			Hush	4375 (-1841)
			BKC	4440 (-1906)
			Ft. Scott	4583 (-2049)
			Conglomerate	4662 (-2128)
			Mississippian	4681 (-2147)
			Dolomite	4693 (-2159)
			2nd dolomite	4707 (-2173)
			Log TD	4743 (-2209)
DST #2, 4708-4720', open 1 hour, very weak blow, rec. 90' muddy water, NS; IBHP 1406# 45 min., FBHP 1388# 45 min.				

USE ADDITIONAL SHEETS, IF NECESSARY, TO COMPLETE WELL RECORD.

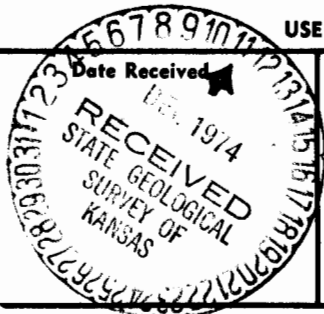

E. J. McNeil
Signature

Exploration Manager
Title

October 17, 1974
Date