


KANSAS

Stafford

Section 25 Township 22 Range 13 W


Well No. #1 Hammeke

Company Auto Ordnance

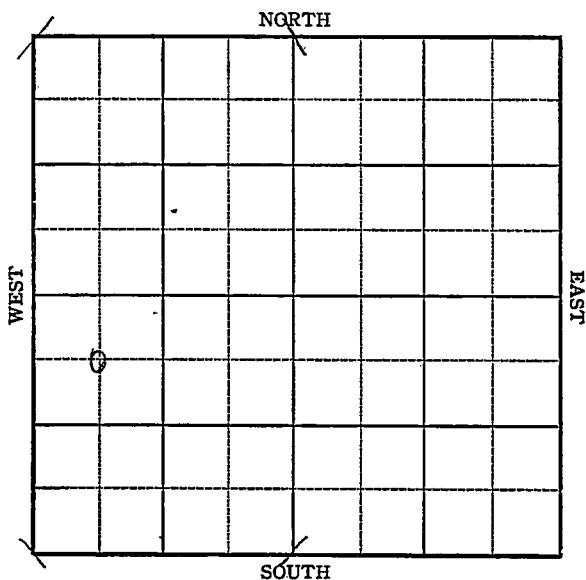

KANSAS

Stafford

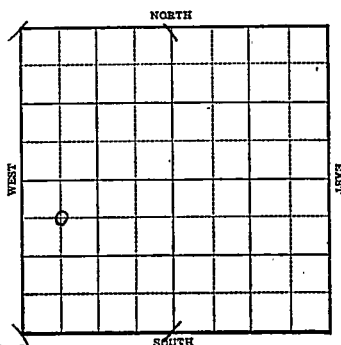Sec. 25 Twp. 22 R. 13-WWell No. #1 Hammeke FarmAuto Ordnance etal Company660 Ft. from N. Line Ft. from S. Line Ft. from E. Line660 Ft. from W. LineElev. 1889

1943

R E P O R T

9/22 Location

9/29 8" $\odot$ 320
Anhy 730
Drlg. 1825'

10/6 Drlg. 2895'

10/13 Topeka 2965
Lans 3388
Viola 3670
Drlg. 3740'10/20 Arb 3775
T.D. 3800
No Shows

ABANDONED

KANSASMap No. 82 Sec. 25 Twp. 22 R. 13WWell No. 1 HammekeAuto Ordnance etal. Company


FIRST REPORT

Contractor

C NW SW

660 Ft. from N. Line Ft. from S. Line Ft. from E. Line660 Ft. from W. Line

SECTION PLAT

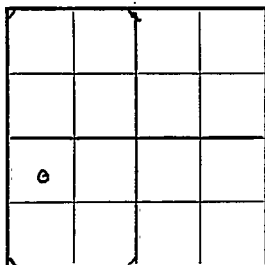WildcatLocation XRig up

Drilling and Remarks:

RECORD

Cased in., ft.Sand Gas Oil Total Depth

PRODUCTION

1st 24 hrs. Nat. 1st 24 hrs. after shot Gas Cu. Ft.Dry Hole Abandoned

Date

SEP 22 1943 19

S. J. LEWIS Scout

KANSAS
 Map No. 25 Sec. 25 Twp. 22 R. 13W

Well No. 1 Hammeke

Auto Ordnance etal. Company

ABANDONED Contractor

C IW SW


SECTION PLAT

660 Ft. from N. Line

 Ft. from S. Line

 Ft. from E. Line

660 Ft. from W. Line

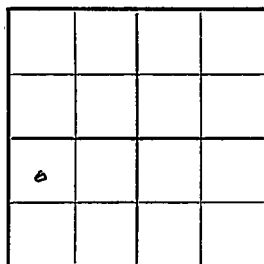

Wildcat

Location

Rig up

Drilling and Remarks:

Cu 43775

No show

RECORD

Cased in., ft.

Sand

Gas

Oil

Total Depth 3800

PRODUCTION

1st 24 hrs. Nat.

1st 24 hrs. after shot

Gas Cu. Ft.

Dry Hole

Abandoned

Date

OCT 20 1943

19

S. J. LEWIS

Scout