


Section 25 Township 22 Range 11W
Well No. 1 H. B. Ross
Company Stanolind

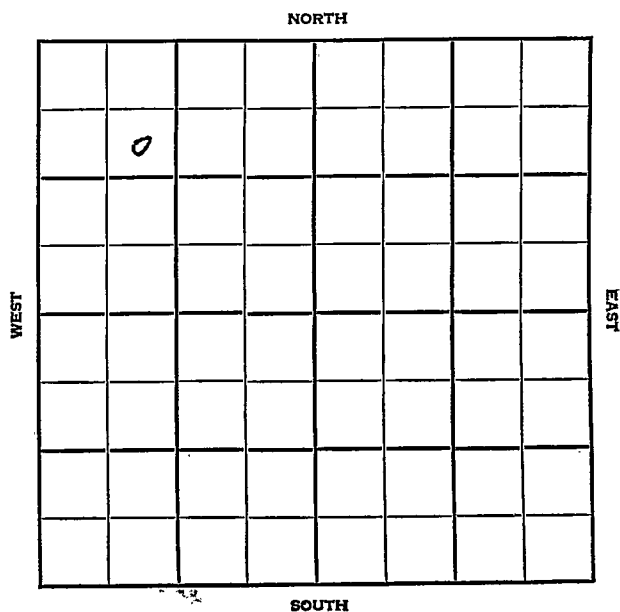

Stafford

KANSAS

SEC.	TWP.	R.
25	22	14 W

WELL NO.

1 H. B. Ross

FARM

COMPANY

Stanolind

CONTRACTOR

Prime Drlg.

S. Oscar Pool


990 Ft. from N. Line

Ft. from S. Line

Ft. from E. Line

990 Ft. from W. Line

SE NW NW

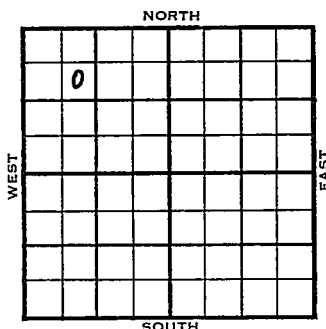

ELEVATION

REPORT

1955

1923'

2/9

MIR

3/2

Spud 2-8-55 - D&A

TD 3900'

8" @ 319'

Lans. 3460'

DST 3584-3626', opn 1 hr., rec. 105' mud, 1100#

DST 3634-50', opn 1 hr., rec. 7' mud, 80#

Viola 3731'

DST 3731-74', opn 1 hr., rec. 25' mud, 52#

Arb. 3858'


TD 3871'

DD 3900'

D&A

ABANDONED

FABEN GILSTRAP

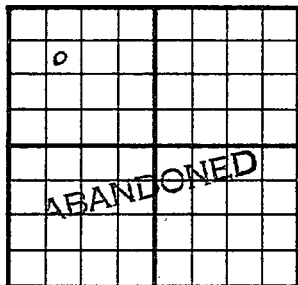County Stafford State KansasSec. 25 (Blk. 22 (Sur. 14W Map No.)
(Twp.) (Rge.)Operator StanolindWell No. 1 Farm H. B. RossElev. 1923 Location SE NW NW990 Ft. From N Line NW990 Ft. From W Line Quarter1st. Report Completion MAR 2 1955Remarks S. Oscar PoolPrime Drlg. - Contr.Spudding Date 2-8-55Drlg. Data D & A TD 39008" @ 319 Lans. 3460 DST 3584-3626open 1 hr. Rec. 105' mud 1100#DST 3634-50 open 1 hr. Rec. 7' mud80# Viola 3731 DST 3731-74open 1 hr. Rec. 25' mud 52#Arb. 3858 TD 3871 DD 3900D & A

FABEN GILSTRAP