

KANSAS

Reno

Sec. 25 Twp. 22 R. 5W

Well No. #1 Dodge Farm

Skelly

Company

Buhler Pool


Ft. from N. Line

330' Ft. from S. Line

330' Ft. from E. Line

Ft. from W. Line

SE NE

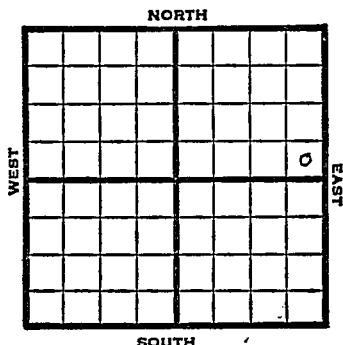

1948

Elev. 1502' REPORT

11/23

RUR

11/30

8" @ 492'

Drlg 1500'

12/6

2180' SD

12/14

2180' SD

12/22

Drlg. 3450'

12/9

Miss 3370'

Viola 3855'

Simpson Sd 3873'

TD 3877'

1/5

5" @ 3873'

1/12

TD 3877 sw & 51 bbls oil

90 w 24 hrs

1/19

"

1/26

Correction Hunton 3868'

Simpson 3868'

Simpson Sand 3869' -

TD 3877'

5" @ 3869'

2/2

"

2/9

"

2/16

Simp 3869'

5" @ 3869'

Pump 55 oil & 50 W Pot.

TD 3877'

Gr. 38,50

COMPLETED

Map No. _____ Sec. 25 Twp. 22 R. 5W

Well No. 1 Dodge

Skelly _____ Company

FIRST REPORT _____ Contractor

SE NE


SECTION PLAT

_____ Ft. from N. Line

330 _____ Ft. from S. Line

330 _____ Ft. from E. Line

_____ Ft. from W. Line

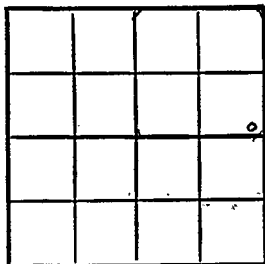

Reno County

Location _____

Rig up _____

Drilling and Remarks:

R U R

RECORD

Cased _____ in., _____ ft.

Sand _____

Gas _____

Oil _____

Total Depth _____

PRODUCTION

1st 24 hrs. Nat. _____

1st 24 hrs. after shot _____

Gas _____ Cu. Ft.

Dry Hole _____

Abandoned _____

Date

NOV 23 1948 19

S. J. LEWIS Scout

Kansas

Map No. K48 Sec. 25 Twp. 22 R. 5WWell No. 1 Dodge

Skelly

Company

COMPLETE

Contractor

SE NE

E 11502
SECTION PLAT Ft. from N. Line330 Ft. from S. Line330 Ft. from E. Line Ft. from W. Line

			0

Reno County

Location Rig up

Drilling and Remarks:

*Surf. 3869**5-3869**Run 550 ft to 1000*
*S. J.**385 ft*

RECORD

Cased in., ft.Sand Gas Oil Total Depth 3877

PRODUCTION

1st 24 hrs. Nat. 1st 24 hrs. after shot Gas Cu. Ft.Dry Hole Abandoned

Date

FEB 16 1949 19

S. J. LEWIS Scout