

Section 25 Township 22 Range 5 W

Well No. # 5 Dodge

Company Skelly Oil

NORTH

WEST

EAST

9

SOUTH

Reno

KANSAS

Sec. 25 Twp. 22 R. 5W

Well No. #5 Dodge Farm ☒

Skelly Oil Company

Contractor


Ft. from N. Line

330 Ft. from S. Line

330 Ft. from E. Line

Ft. from W. Line

SE SE NW

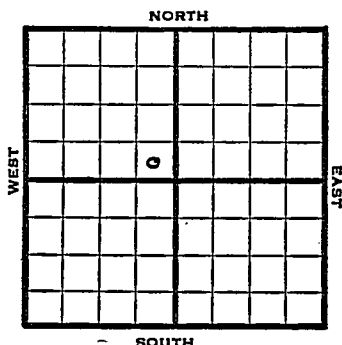

1952

Elev. 1528'

REPORT

4/2

Spud 3-24-52
13" @ 135'
Drlg. 1935'

4/9

Drlg. 3609'

4/23


Br Li 2674 Lans. 2703
Miss 3394 KH 3639
Htn 3758 Mq 3777
V 3870 Simp 3889-92
RTD Fill up 1000' oil 1 hr.
S/119 BO & 3 BW 10 hrs.
800' off Btm

4/30

Spud 3-24-52
Oil Well TD 3893 12" @ 135
Br Li 2674 Lans. 2703
Miss. 3394 Kh. 3639 Hun 3758
Maq. 3777 Viola 3870
Simp. 3889-92 TD 5" @ 3890
DD 3893 FU 1000' oil 1hr.
S/ 119 bo 3 bw 10 hr.
Comp. 150 bopd 4 bw

COMPLETED

County Reno State Kansas
Sec. 25 (Blk. Twp.) 22 (Sur. Rge.) 5W Map No.
Operator Skelly Oil
Well No. 5 Farm Dodge
Elev. _____ Location SE SE NW

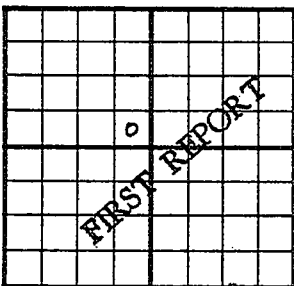


330 Ft. From S Line NW
330 Ft. From E Line Quarter
1st. Report APR 2 1952
Completion _____
Remarks _____
Spudding Date 3-24-52

Drlg. Data

13" @ 135 Drlg. 1935

J. G. McGEHEE

County Reno State Kansas
 Sec. 25 (Blk.) 22 (Sur.) 5W Map No.
 Operator Skelly Oil
 Well No. 5 Farm Dodge
 Elev. 1528 Location SE SE NW

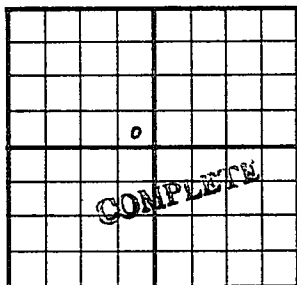

330 Ft. From S Line NW
330 Ft. From E Line Quarter
 Ist. Report
 Completion APR 30 1952
 Remarks

Spudding Date 3-24-52

Drilg. Data Oil well TD 3893
13" @ 135 Br. lime 2674 Lans. 2703
Miss. 3394 Kh. 3639 Hunton 3758
Maq. 3777 Viola 3870 Simp. 3889-92 TD
5" @ 3890 DD 3893 FU 1000' oil 1 hr.
S/ 119 bo 3 bw 10 hr.
Comp. 150 bopd 4 bw

J. G. McGEHEE