

KANSAS


Reno

Section 25 Township 22 Range 5W

Well No. 1 Dodge SWD

Company Skelly

Buhler

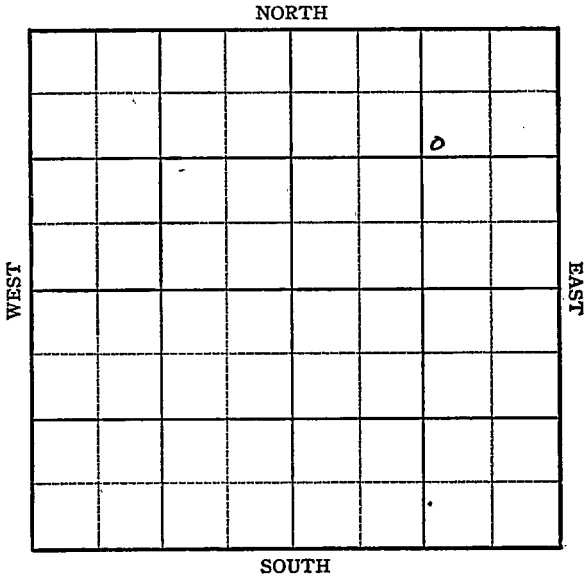

KANSAS

Reno



Sec. 25 Twp. _____ R. 22 5W

Well No. #1 Dodge SWD Farm _____

Skelly Company _____


Buhler Pool

1200' Ft. from N. Line

_____ Ft. from S. Line

1200' Ft. from E. Line

_____ Ft. from W. Line

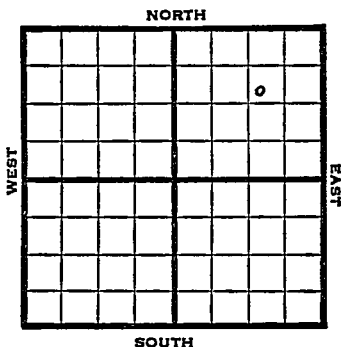

SW NE NE

1949

R E P O R T

3/9 10" @ 25'
8" @ 105'
7" @ 490'
Drlg. 500'

3/16 TD 661'
Wtr input 60 bbls PH

3/23 TD 661'
7" @ 490'
SWD
Aband.

ABANDONED

Map No. _____ Sec. 25 Twp. 22 R. 5W

Well No. 1 Dodge SWD

Skelly Company

FIRST REPORT Contractor

SW NE NE

SECTION PLAT

1200 Ft. from N. Line

_____ Ft. from S. Line

1200 Ft. from E. Line

_____ Ft. from W. Line

			o

Reno County

RECORD

Location _____

Rig up _____

Drilling and Remarks:

10" @ 25

8" @ 105

7" @ 490

drlg. 500

Cased _____ in., _____ ft.

Sand _____

Gas _____

Oil _____

Total Depth _____

PRODUCTION

1st 24 hrs. Nat. _____

1st 24 hrs. after shot _____

Gas _____ Cu. Ft.

Dry Hole _____

Abandoned _____

Date

MAR 9 1949 19

S. J. LEWIS

Scout

Kansas

Map No. K48 Sec. 25 Twp. 22 R. 5W

Well No. 1 Dodge SWD

Skelly Company

ABANDONED Contractor

SW NE NE

SECTION PLAT

1200 Ft. from N. Line

_____ Ft. from S. Line

1200 Ft. from E. Line

_____ Ft. from W. Line

Reno County

RECORD

Location _____

Cased _____ in., _____ ft.

Rig up _____

Sand _____

Drilling and Remarks:

Gas _____

7" C490

Oil _____

Total Depth 661

SWD

PRODUCTION

1st 24 hrs. Nat. _____

1st 24 hrs. after shot _____

Gas _____ Cu. Ft.

Dry Hole _____

Abandoned _____

Date

MAR 23 1949 19

S. J. LEWIS Scout