


Section 25 Township 22 Range 5W

Well No. #2 O.D. Dodge

Company Skelly Oil

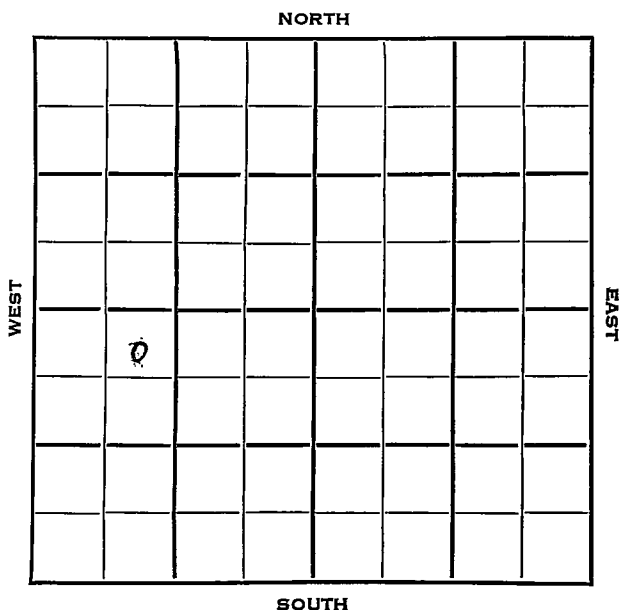

Reno

KANSAS

SEC.	TWP.	R.
25	22	5W

WELL NO.

#2 O.D. Dodge

FARM

COMPANY

Skelly Oil

CONTRACTOR


Buhler Pool

330 Ft. from N. Line

Ft. from S. Line

Ft. from E. Line

990 Ft. from W. Line

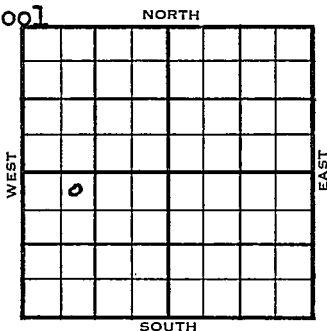

NE NW SW

	ELEVATION	REPORT
1954	1537'	

3/10

Location

3/17

8" @ 757' w/250 sks

Drlg. 2065'

3/24

Drlg. 3585'

3/31

Lans 3732', Miss 3401', Kh 3633'
 Meisner 3765', Htn 3770', V 3890'
 Simp sd 3907'
 RTD 3908'
 5" @ 3907'

4/7

DD 3915'
 7 bw 4 hrs.,
 DD 3922'
 S/1-3/4 BO + 54 BW 6 hrs.

4/14

Spud 3-8-54
 Oil Well,
 TD 3922'
 8" @ 757'
 Lans 2732', Miss 3401', Kh 3633',
 Meisner 3765', Hunton 3770', Viola
 3890', Simp. 3907'
 TD 3908'
 5" @ 3907'
 DD 3915, 7 bwph 4 hrs., DD 3922
 S/ 1 3/4 bo 54 bw 6 hrs.
 Comp. 20 bopd 100 bw

COMPLETED

