

KANSAS


FORM 51 5M 2-38 TPCO.

Reno

Section 25 Township 22 Range 5-W


Well No. 1 Johns

Company Amerada & Westgate Greenland

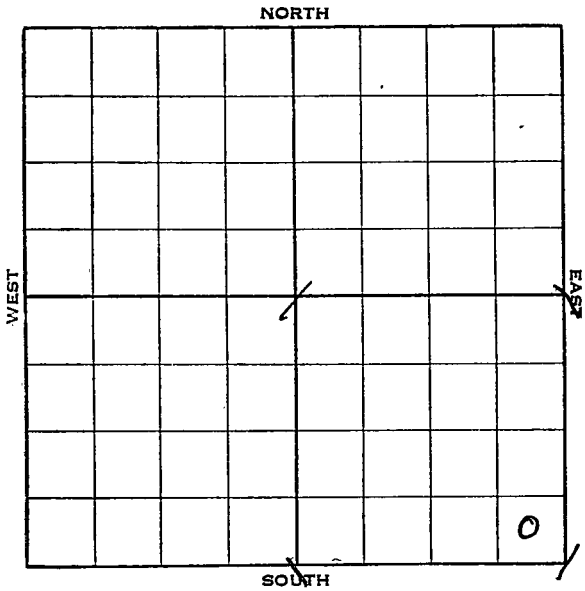

Sec. 25 Twp. 22 R. 5-WWell No. #1 Johns FarmAmerada & Westgate Greenland Company Ft. from N. Line330 Ft. from S. Line330 Ft. from E. Line Ft. from W. Line

Elev. 1525

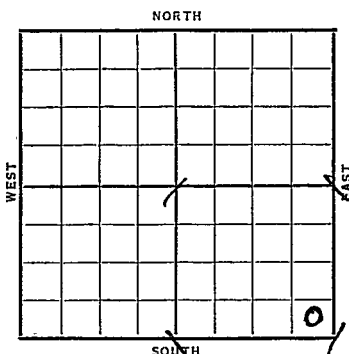

Date	REPORT
1938	
2/23	Mat'l.
2/26	"
3/4	S. H.
3/11	13" @ 150'. Anhy 420'. Fort Riley 975'. Drlg. 1570'.
3/18	Topeka 2165'. K. C. 2715'. T.D. 3320' Fsg.
3/25	Chat 3391'. Drlg. 3690'.
4/1	Base Miss. 3636'. Misner 3759'. Hunton 3763'. Sylvan 3773'. Viola 3879'. S.O. 3898-3902'. Wilcox 3896'. T.D. 3902'. Core also showed gas. 7" @ 3893'. Drilled plug. Filled 3000' oil 12 hrs. Gravity 37.
4/5	Pumped 173 bbls. in 4 hours Pumped 152 bbls. in 4 hrs. 24 hour potential 912 bbls. Gravity 37 (Tel)
	OVER

1938

4/6

7" @ 3893'.

Wilcox 3896'.

T.D. 3902'.

Potential 912 bbls.

Gravity 40.

COMPLETED

Map No. 48 Sec. 25 Twp. 22 R. 5WWell No. 1 JohnsAmerada & Westgate Greenland
Company


Contractor

FIRST REPORT

SE/C

 Ft. from N. Line330 Ft. from S. Line330 Ft. from E. Line Ft. from W. Line

SECTION PLAT

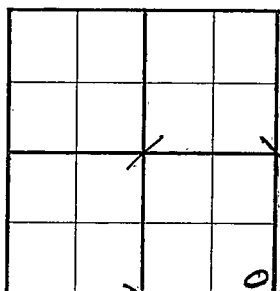Location Rig up

Drilling and Remarks:

Matl.

RECORD

Cased in., ft.Sand Gas Oil Total Depth

PRODUCTION

1st 24 hrs. Nat. 1st 24 hrs. after shot Gas Cu. Ft.Dry Hole Abandoned

Date

FEB 23 1938

19

H. D. Hatfield Scout

Reno

KANSAS

Map No. 48 Sec. 25 Twp. 22 R. 5WWell No. 1 Johns Greenland
Amerada & Westgate Company

Contractor

COMPLETED
SE/C Ft. from N. Line330 Ft. from S. Line330 Ft. from E. Line Ft. from W. Line

SECTION PLAT

			0

Location Rig up

Drilling and Remarks:

POT 912
grav. 40.

RECORD

Cased 7 in., 3893 ft.Sand Wilcox 3896Gas Oil Total Depth 3902

PRODUCTION

1st 24 hrs. Nat. 1st 24 hrs. after shot Gas Cu. Ft.Dry Hole Abandoned

Date

APR 6 - 1938 19 H. D. Hatfield Scout