FORM 51 25M 3-49 PETROL


Reno

KANSAS

Section 25 Township 22 Range 5 W

Well No. # 3 Johns

Company Amerada Petroleum

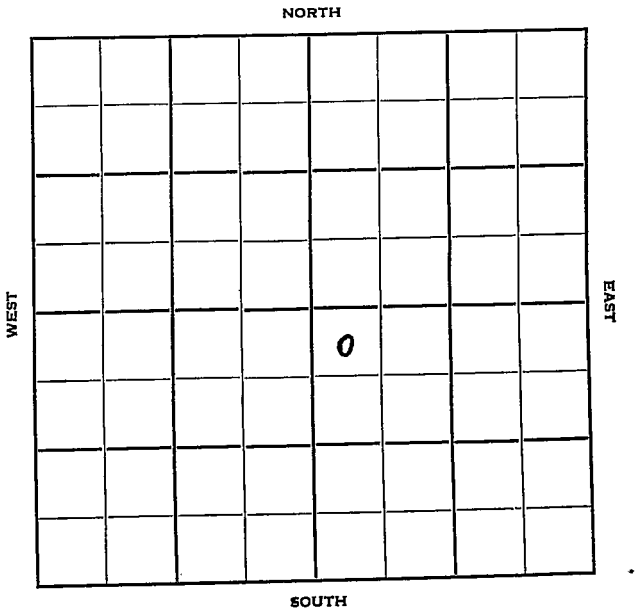

FORM 252-B
10M 8-51 TPCO.

Reno KANSAS ✓

Sec. 25 Twp. 22 R. 5W

Well No. #3 Johns Farm

Amerada Petroleum Company

Contractor


330' Ft. from N. Line

Ft. from S. Line

Ft. from E. Line

330' Ft. from W. Line

NW NW SE

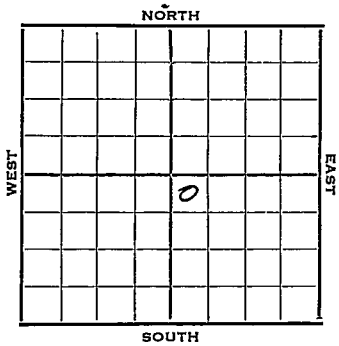

1952	Elev. 1526' REPORT
5/14	Location
5/21	"
5/28	"
6/11	"
6/18	"
6/25	13" @ 124' 3883 8" @ 689' 1526
7/2	Drlg. 1429' 2357
7/9	Lans. 2700' Miss 3387' Drlg. 3442'
7/17	KH 3632' Htn 3757' V 3866' Simp. 3883' RTD 3887' Schl 5" @ 3884'
7/23	CO 3887 S/ 10 galo & 10 galwph DD 3889 S/ 24 BO & 16½ BWPD DD 3891 TD S/ 49 Bo & 21 BW 11 hrs. POP
7/30	NR
8/6	"
8/13	"
8/20	"
8/27	"
9/3	"
9/10	Spud 6-21-52 Oil Well TD 3891' 13" @ 124 ' 8" @ 689

OVER

1952

9/10 Lans. 2700 Miss. 3387
Kh. 3632 Hunton 3757
Simp. 3883
TD 3887 5" @ 3884 CO to 3887
S/ 10 go 10 gwph DD 3889
S/ 24 bo 16½ bwpd DD 3891
S/ 49 bo 21 bw 11 hr.
Comp. 50 bopd 21 bw

COMPLETED

FORM 275 FOR SALE BY KANSAS BLUE PRINT CO.


County Reno State Kansas

Sec. 25 (Blk. Twp.) 22 (Sur. Rge.) 5W Map No.

Operator Amerada Petroleum

Well No. 3 Farm Johns

Elev. Location NW NW SE

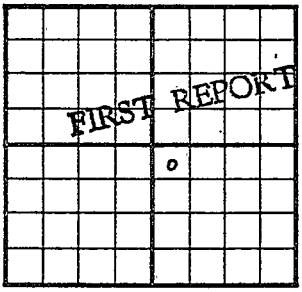

330 Ft. From N Line SE

330 Ft. From W Line Quarter

1st. Report MAY 14 1952

Completion

Remarks

Spudding Date

Drlg. Data

Location

J. G. McGEHEE

FORM 275 FOR SALE BY KANSAS BLUE PRINT CO.


County Reno State Kansas

Sec. 25 (Blk. Twp.) 22 (Sur. Rge.) 5W Map No.

Operator Amerada Petroleum

Well No. 3 Farm Johns

Elev. 1526 Location NW NW SE

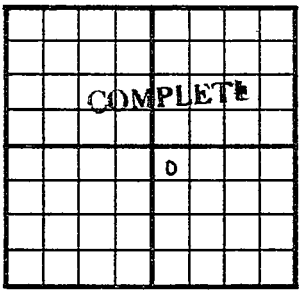

330 Ft. From N Line SE

330 Ft. From W Line Quarter

1st. Report

Completion SEP 1 0 1952

Remarks

Spudding Date 6-21-52

Drlg. Data Oil well TD 3891

13" @ 124 8" @ 689 Lans. 2700

Miss. 3387 Kh. 3632 Hunton 3757

Simp. 3883 TD 3887 5" @ 3884

CO to 3887 S/ 10 go 10 gwph DD 3889

S/ 24 bo 16½ bwpd DD 3891

S/ 49 bo 21 bw 11 hr.

Comp. 50 bopd 21 bw

J. G. McGEHEE