


Section 25 Township 22 Range 33W
Well No. 2 Holsted-Thomason
Company W. L. Hartman

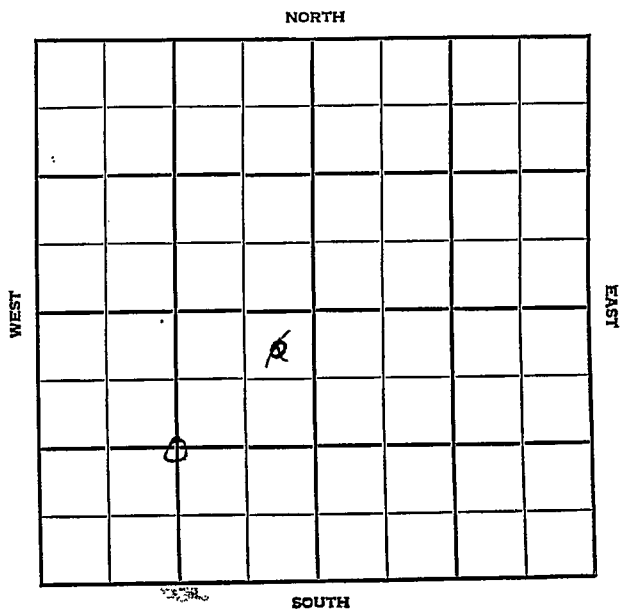

Finney KANSAS

SEC.	TWP.	R.
25	22	33W

WELL NO.

2 Holsted-Thomason

FARM

COMPANY

W. L. Hartman

CONTRACTOR

H & H Drlg.

E. Finnup Pool

~~1370~~
~~330~~


Ft. from N. Line

Ft. from S. Line

~~1370~~
~~330~~

Ft. from E. Line

Ft. from W. Line

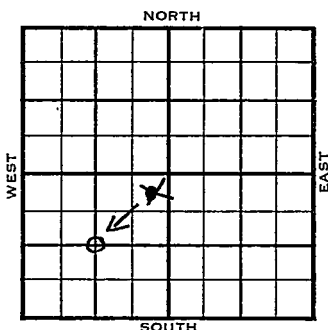

c sw/4

~~NE NE SW~~

1954	ELEVATION	REPORT
	2866'	

8/25

Spud 8-22-54

10" @ 245'

Drlg. 1380'

19/29

Spud 8-22-54 - Gas Well

TD 2698'

10" @ 245'

Hol. 2510', Her. 2537', Kri 2563',
Odell 2580', Win. 2600', Gage 2626',
Ft. Riley 2658'

TD 2698'

7" @ 2698'

Comp. 10,044,000 cf gpd

COMPLETED

Kansas

Map No. _____ Sec. 25 Twp. 22 R. 33WWell No. 2 Halsted-Thomason

W. L. Hartman


Company

CORRECTION

Contractor

C SW/4

SECTION PLAT

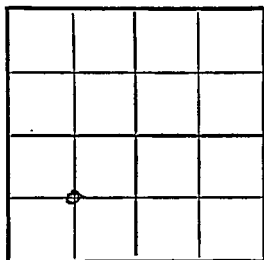1320 Ft. from N. Line

_____ Ft. from S. Line

1320 Ft. from E. Line

_____ Ft. from W. Line

Finney County

Location _____

Rig up _____

Drilling and Remarks:

Reported

NE NE SW

RECORD

Cased _____ in., _____ ft.

Sand _____

Gas _____

Oil _____

Total Depth _____

PRODUCTION

1st 24 hrs. Nat. _____

1st 24 hrs. after shot _____

Gas _____ Cu. Ft.

Dry Hole _____

Abandoned _____


Date

AUG 25 1954

FABEN GILSTRAP

Scout

County Finney State Kansas
Sec. 25 (Blk.) 22 (Sur.) 33W Map No.
Operator W. L. Hartman
Well No. 2 Farm Holsted-Thomason
Elev. 2866 Location C SW

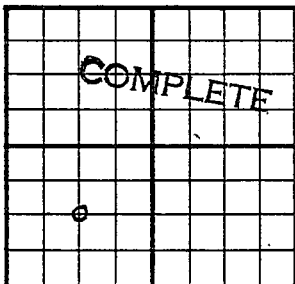

1320 Ft. From N Line SW
1320 Ft. From E Line Quarter
1st. Report Aug 25 1954
Completion SEP 29 1954

Remarks H & H Drlg. - Contr.
Spudding Date 8-22-54

Drlg. Data Gas well TD 2698 E. Finnup Pool
10" @ 245 Hol. 2510 Her. 2537
Kri. 2563 Odell 2580 Win. 2600
Gage 2626 Ft. Riley 2658 TD 2698
7" @ 2698 Comp. 10,044,000 cf gpd

FABEN GILSTRAP