

Section 25 Township 22 Range 33 WWell No. # 1 ThomasonCompany W. L. Hartman

0							

NORTH

WEST

EAST

SOUTH

KANCA

SEC.	TWP.	R.
25	22	33 W ✓
WELL NO.		
# 1 Thomason FARM		
COMPANY		
W. T. Hartman		
CONTRACTOR		

_____ Ft. from N. Line

330


Ft.-from S. Line

Ft. from E-Line

330

Ft. from W. Line

SW SW SW
Texas & CSO - DHM

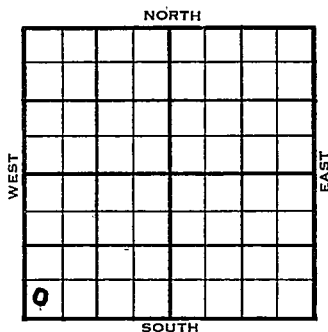

	ELEVATION	REPORT
1953	2867'	Miss. test
10/14	Spud 10-10-53 10" @ 265'	
10/21	Hol. 2512', Her. 2538', Kr. 2560', Codell 2579', Win 2595', Gage 2626', Up Ft. 2651', Low Ft. 2720', F Flint 2750' Drlg 3110'	
10/28	DST 3812'-46' 1½ hr, 136' sw, 1310# Heeb 3819', Lans. 3859'	
1954 1/13	Spud 10 10-10-53 Oil well TD 4905' 10" @ 265' Hol. 2512' Her. 2538' Kri. 2560' Codell 2579' Win 2595' Gauge 2626' Ft. Riley 2651' F. flint 2750' DST 3812-46 open 1½ hr rec 136' SW 1310# Heeb 3819' Lans. 3859' DST 4308-38 open 1 1 hr. rec 810' sul wtr. 1080# Marm. 4350' DST 4378-4410 open 1 hr rec 175' O & GCM 1025# DST 4400-10, open 1 hr rec 90' oil 1020# DST 4435-60 open 1 hr rec 1110' gas, 150' SOCM, 60' HOCM, 120' MCO 1200 1090#	

OVER

1954

1/13

(Information continued)

DST 4481-97 open 1 hr. rec 35' mud
90# Cherokee 4488'

DST 4590-4620, failed.

DST 4590-4620' open 10 min, rec 600'
mud. 0# Patterson sd 4663'

Miss. 4704'

DST 4774-98, open 1 hr rec 20' mud
110# TD 4905' 5" @ 4670 18/4612-

18 18/4598-4604 24/4577-85 SS0

24/4585-93 48/4577-93 SP 4476

48/4442-58 SO 500 A S/4 BOPH

S/7 BFPH 9% wtr. P/59 BF 18 hr.

5% wtr. P/55 BO 24 hr.

Comp. 232 BOPD

COMPLETED

J. G. McGEHEE

J. G. McGEHEE

1-1-68 MISC. MISC.

Patterson sd. 4663 Miss. 4704

DST 4774-98 ~~open 1 hr.~~ Rec-20 muc

110# TD 4905 5" @ 4670 18 4612 18

18/ 4598-4604 ~~24/ 4577-85 SSO~~

24/ 4585-93 48/ 4577-93 SP 4476

48/ 4442-58 S.O 500 A S/ 4 boph

S/ 7 bfph 9% wtr. P/ 59 bf /18 hr.

5% wtr. P/ 55 bo 24 hr.

Comp. 232 bopd

JAN 19 1954

[illegible]