


Section 25 Township 22 Range 34W

Well No. 1 W. L. Ulrich

Company TexasCompany

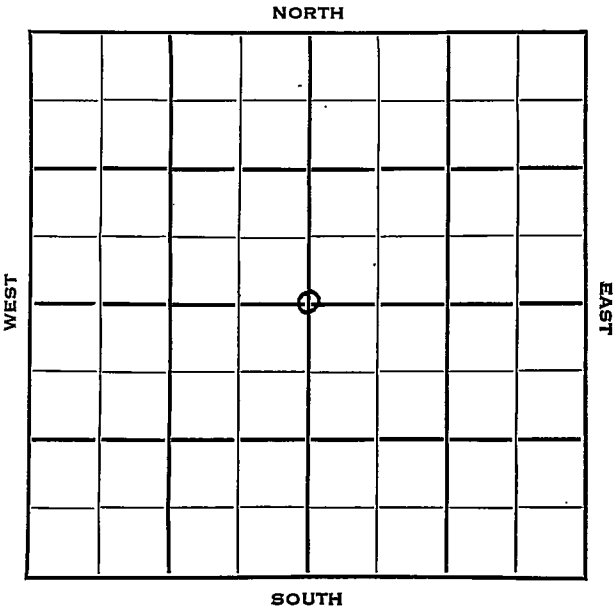

Finney

KANSAS

SEC.	TWP.	R.
25	22	34W

WELL NO.

#1 W.L. Ulrich

FARM

COMPANY

Texas Company

CONTRACTOR

Stickle Drlg.

Hugoton Pool

2640


Ft. from N. Line

Ft. from S. Line

Ft. from E. Line

2640

Ft. from W. Line

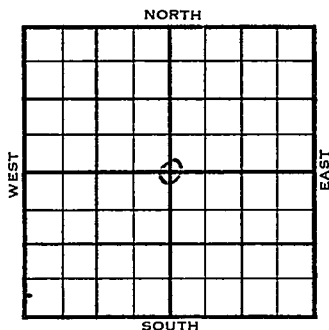

C Sec.

	ELEVATION	REPORT
1954	2924'	

1/27

Spud 1-25-54

10" @ 502'

Drlg 503'

2/3

Her 2551', Kr. 2572', Win 2610'

TD 2656'

7" @ 2655'

2/10

C.O. 2636'

33/ 2612-28 64/ 2554-84 A-frac

2/17

Spud 1-25-54 Gas well TD 2656

10" @ 502' Her 2551' Kri 2572

Win 2610 TD 2656' 7" @ 2655


CO to 2636 33/2612-28 64/2554-84

A-frac. Comp. 13,727,000 gas 375#

COMPLETED

10" @ 502 drlg. 503

County Finney State Kansas
 Sec. 25 (Blk.) 22 (Sur.) 34W Map No.
 Operator Texas Company
 Well No. 1 Farm W. L. Ulrich
 Elev. 2924 Location C Sec.

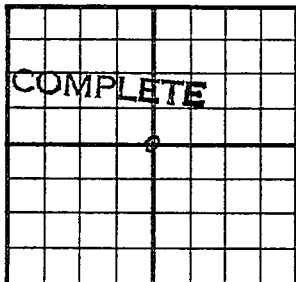

2640 Ft. From N Line Sec.

2640 Ft. From W Line Quarter

1st. Report

Completion FEB 17 1954

Remarks Hugoton Pool
Stickle Drlg. - Contr.

Spudding Date 1-25-54

Drlg. Data Gas well TD 2656

10" @ 502 Her. 2551 Kri. 2572

Win 2610 TD 2656 7" @ 2655

CO to 2636 33/ 2612-28 64/ 2554-84

A-frac Comp. 13,727,000 gas 375#

J. G. McGEHEE