


DX 78-1 STAFFORD

KANSAS

Section 26 Township 22 Range 12W

Well No. 1 Sandifer

Company Shelly-Miller Drlg Inc

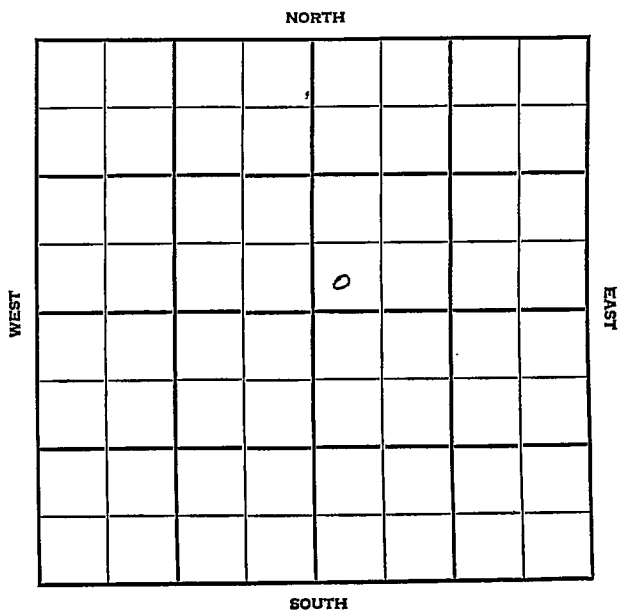

Stafford

KANSAS

SEC.	26	TWP.	22	R.	12W
------	----	------	----	----	-----

WELL NO. #1 Sandifer FARM

COMPANY Shelley-Miller Drlg. Inc.

CONTRACTOR Co. Tools.


Pleasant Grove Pool

_____ Ft. from N. Line

330 _____ Ft. from S. Line

_____ Ft. from E. Line

330 _____ Ft. from W. Line

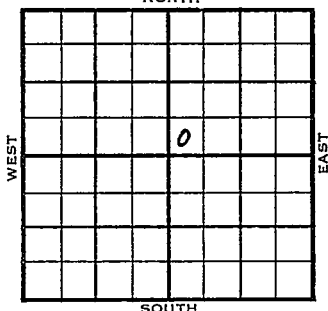

SW SW NE

1955	ELEVATION 1840'	REPORT
------	--------------------	--------

3/30 R U R
 4/13 Spud 3-28-55 - D&A
 TD 3662'
 8" @ 228'
 Anhy 592', Heeb. 3125', Br lime
 3259', Mans. 3282'
 DST 3411-40', opn 1 hr., rec. 120'
 gas, 60' SO&GCM, 120' thin mud, 0 #
 DST 3475-3500', opn 45", rec. 35' mud,
 260#
 Cong. 3558', Viola 3566', Simp 3604'
 TD 3662'
 D&A

ABANDONED

